

## WATER SERVICE RECORD

Name Vito Cannalunga

Service No. 43

Address 945 Waltham Street

Location

~~Repair~~ ~~Work~~ - New Service


Conn 5940

Date	Material	Amount	Total	Date	Amount	
4-27-60	Labor	58 19		4-27-60	Deposit	200 00
	10 % O.H.	5 82	64 01	5-9-60	Retard	63 20
	75' 3/4" Copper tubing @.42		31 50			136 80
	1 3/4" Cx1/2 IWHS Stop & Waste		6 14		NON CHARGE	
	1 3/4" C3 Part Union		2 40		Labor	7 76
	2x3 Patch		2 00		2' 3/4" Copper tubing @.42	.84
	5 1/2 Hrs Town shovel @4.50		24 75		1 3/4" C Corp Cock	4 91
	2 Hrs Trucking @3.00		6 00		1 3/4" C Curb Cock	6 28
			136 80		1 1/2 Straight tailpiece	.50
					1 1/2 Offset tailpiece	.50
					1/2 hr. Town Shovel @4.50	2 25
						23 04

TOWN OF LEXINGTON — BOARD OF PUBLIC WORKS

WATER DIVISION

Sketch of Service Here

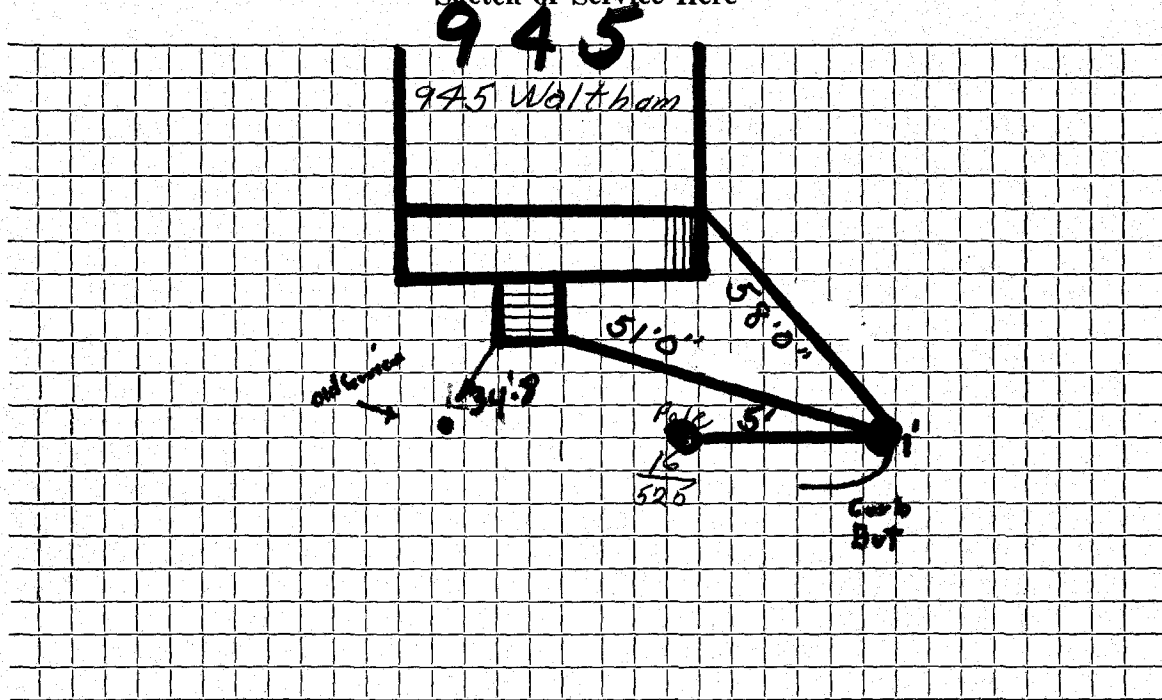

Connection made in ..... Street. Work completed .....

Remarks: .....  
.....  
.....