

WATER SERVICE RECORD

Name Douglas Coburn

Service No. 21423

Address 952 Waltham Street

Location

New Service W.O. # 2303

FEB 10 1975


Date		Material	Amount		Total		Date	Amount
8-15-74		Labor	175	84			1 Hr. Loader @ 4.00	4.00
8-15-74		Labor	30	00			1½ Hr. Trailer @ 1.00	1 50
8-27-74		Labor	47	26				
8-28-74		Labor	92	16	345	26	8-28-74 54' ¾ Copper	833.21
		10% O.H.	34	53	379	79	7-29-74 Deposit	500.00
	57'	3/4" Copper Pipe	1	05	59	85	8-28-74	500.00
	1	3/4 Corp.	10	53	10	53		
	1	3/4 Curb Cock	12	45	12	45		
	½	Ton Cold Patch	12	15	6	07		
	1	Box and Rod	12	95	12	95		
	5'	x 23' Patch Street			102	16		
	5'	x 20' Sidewalk			88	88		
	5'	x 21' Street			87	78		
	6½	Hr. Trucking	3	00	19	50		
	5	Hr. Backhoe	6	50	32	50		
	2	Hr. Compressor	5	00	10	00		
	1½	Hr. Pick-Up	1	50	2	25		
	1½	Hr. Roller	2	00	3	00		

DATE _____

TOWN OF LEXINGTON — BOARD OF PUBLIC WORKS

WATER DIVISION

Sketch of Service Here

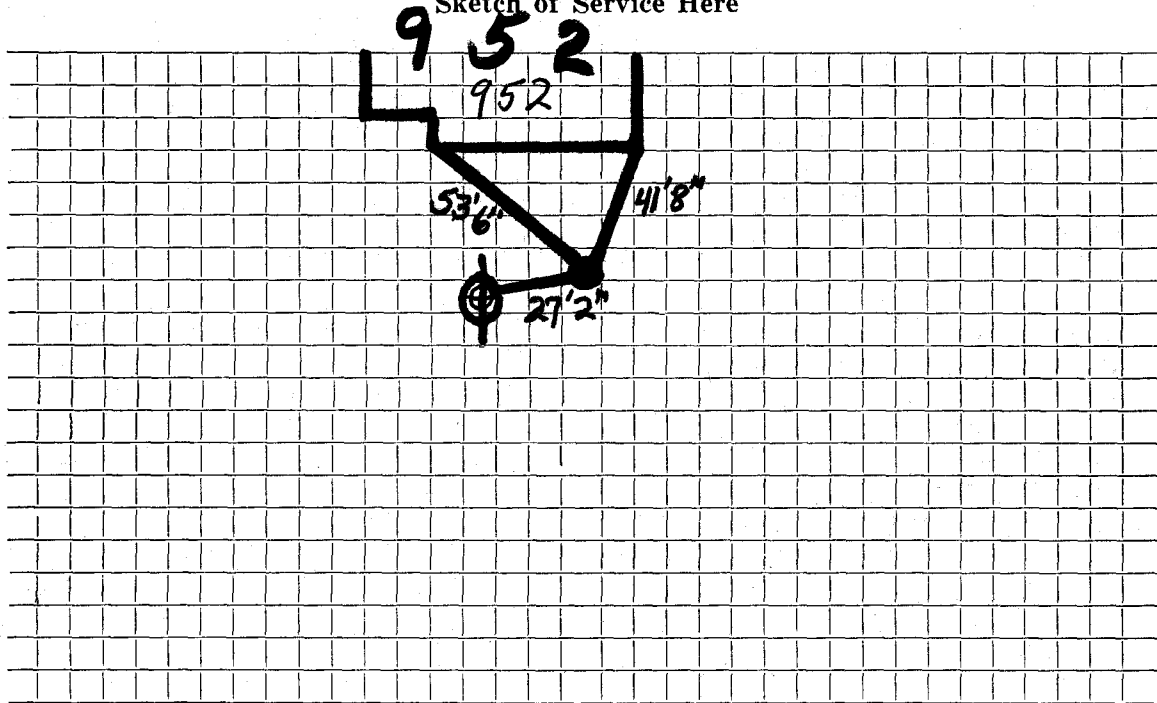

Connection made in Street. Work completed

Remarks:
.....
.....