

WATER SERVICE RECORD

Name *Lexington Lodge #2204 BPO Elks*

Service No. *46*

Address *959 Waltham Street*

Location *DeFlice Bros. Permit #9*

JUN 29 1964
Comm

~~Replaced~~ - New Service *Wot# 8740*

Date		Material	Amount	Total	Date	Amount
<i>6-4-64</i>	<i>148'</i>	<i>Copper Tubing 3/4"</i>			<i>5-7-64</i>	<i>125.00</i>
<i>6-2-64</i>		<i>Labor</i>	<i>75.59</i>		<i>11-18-64</i>	<i>118.37</i>
		<i>10% O.H.</i>	<i>7.56</i>	<i>83.15</i>		<i>233.37</i>
	<i>1</i>	<i>2" Corp Cock</i>		<i>57.01</i>		
	<i>1</i>	<i>6 x 2 Service Saddle</i>		<i>7.04</i>		
	<i>1</i>	<i>2" O R Seal Curb</i>		<i>40.84</i>		
	<i>1</i>	<i>Road Box</i>		<i>12.10</i>		
	<i>2</i>	<i>hrs. Town Shovel @6.50</i>		<i>13.00</i>		
	<i>2</i>	<i>hrs. Trucking @3.00</i>		<i>6.00</i>		
	<i>1</i>	<i>2" Gate Valve</i>		<i>21.13</i>		
				<i>243.27</i>		


Bill sent 7/18/64

DATE _____

TOWN OF LEXINGTON — BOARD OF PUBLIC WORKS

WATER DIVISION

Sketch of Service Here

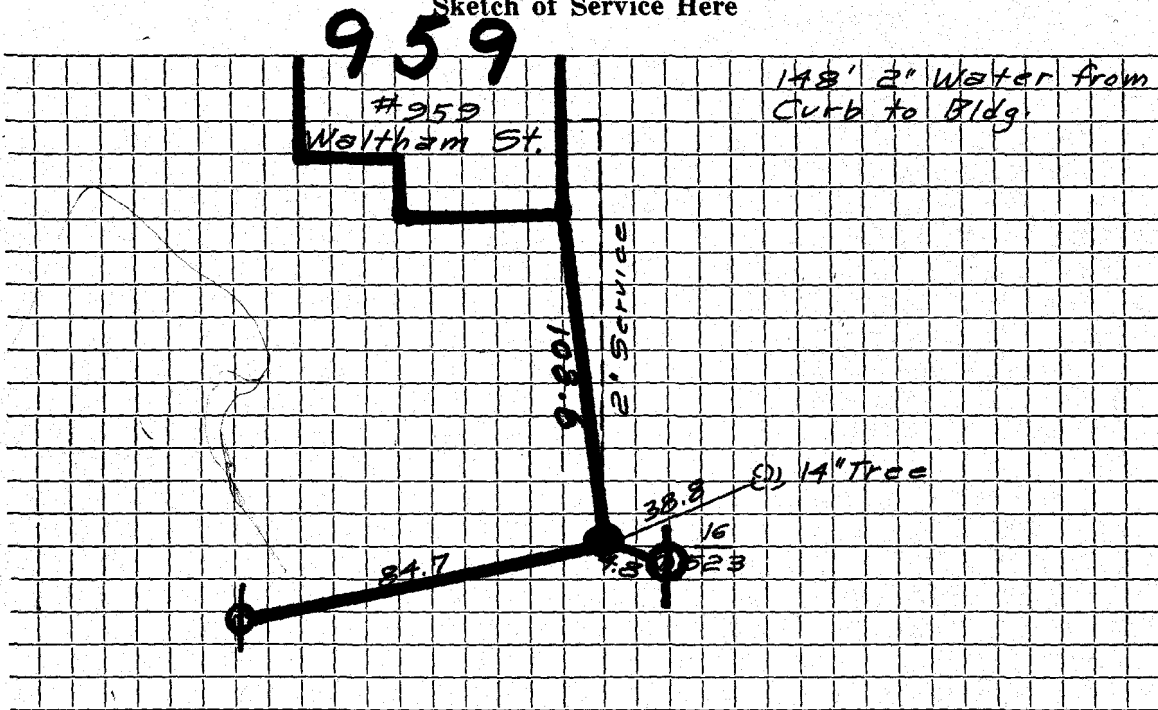

Connection made in Street. Work completed

Remarks:

.....

.....