

WATER SERVICE RECORD

Name

Service No.

Address

960 Waltham Street

Location


~~Repair~~ - Renewal - ~~NEW SERVICE~~ Meter Service Lowered

Date	Material	Amount	Total	Date	Amount
10-13-64	Labor	98.20			
	10% O.H.	9.82	108.02		
	19' 1" Copper tubing @.56		10.64		
	1 1" Union		4.98		CURB TO MAIN
	2 1" 2 part union @2.80		5.60	7' 1" Copper tubing @.56	3.92
	9 ton Gravel @.90		8.10	1 1" Curb Cock	10.66
	72 Barrell Blocks @.32		23.04	1 Box & Rod	4.90
	1 Frame & Cover		10.50	2 tailpiece @.50	1.00
	$\frac{1}{2}$ hr. Town Shovel @6.50		3.25	$\frac{1}{2}$ hr. Town Shovel @6.50	3.25
	$\frac{1}{2}$ hr. Town Truck @3.00		1.50	$\frac{1}{2}$ hr. Trucking @3.00	1.50
	1 hr. Loader		4.00	1 hr. Loader	4.00
			179.63	5 x 3 Patch	5.00
					34.23

TOWN OF LEXINGTON — BOARD OF PUBLIC WORKS

WATER DIVISION

Sketch of Service Here

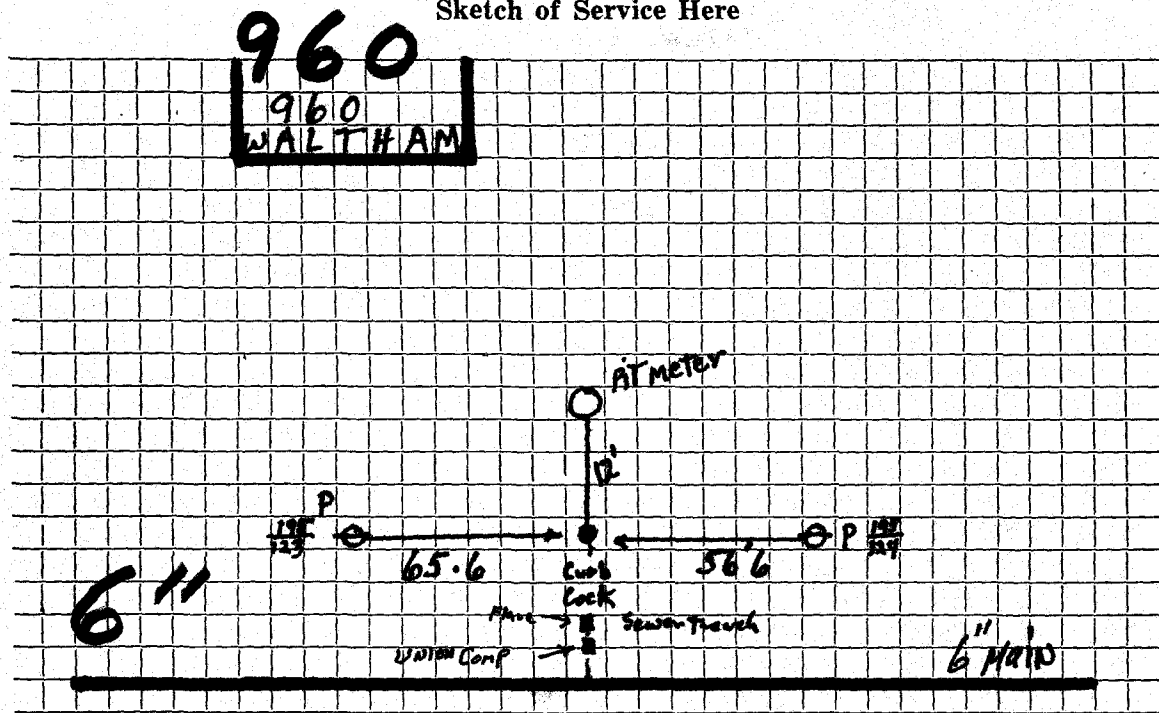

Connection made in Street. Work completed

Remarks: Service broken by Sewer Cont. 11-2-82 2-Union's in Sewer Trench 1"

..... UNION'S 40' + 47' from center of pit cover

Original Service 6-8-46