

Name Catherine F. Little

Service No. ~~59~~ 2886

Address ~~601 Main Street, Watertown,~~

979 Waltham St.

Location <sup>979</sup> ~~1041~~ Waltham Street

Kind of Pipe

Size

Size of Main

Repair—Renewal—New Service

*(Est. by 6x3 = 18. 2 yds @ 300 = 6.00)*

Location

Date  
1937

Material

Amount

Total

Date

Amount

8/27

2 hrs. @ 60¢

1 20

1 20

July 31, 1937

Deposited

31 00

54' Cop. Tubing. @ 25¢

13 50

Oct 14, 1937

Paid

5 00

1 3/4" S. & S.

3 75

2 hrs. Trucking @ 75¢

1 50

19 95

36 00

Flat Rate:

54' @ 50¢

27 00

Construction charge

3 00

Trench Repairs

6 00

36 00

Labor

DATE July 30. 1927.

TOWN OF LEXINGTON—BOARD OF PUBLIC WORKS

WATER DIVISION

*next to weights.*

The undersigned applies for a supply of water at No. ~~1044~~ 979 Waltham St. and hereby agrees to comply with the rules and regulations as now, or at any future time, established by the Board of Selectmen.

Am't. of Estimate \$ 31.00 1/4

Owner

Catherine F. Little

Am't. Paid \$ \_\_\_\_\_

Address


691 Main St.

Builder \_\_\_\_\_

*mid x  
7083 st.*

Watertown Mass

Sketch of Service Here

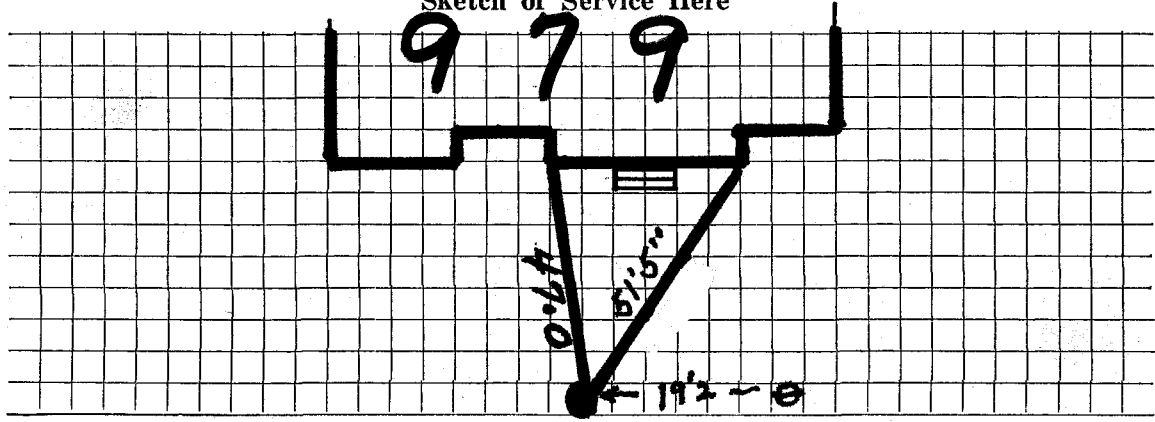

Connection made in \_\_\_\_\_ Street.

Work completed \_\_\_\_\_ 19

Remarks: