




DATE 5/90  
P.A.B.

TOWN OF LEXINGTON — BOARD OF PUBLIC WORKS

WATER DIVISION

Sketch of Service Here

983

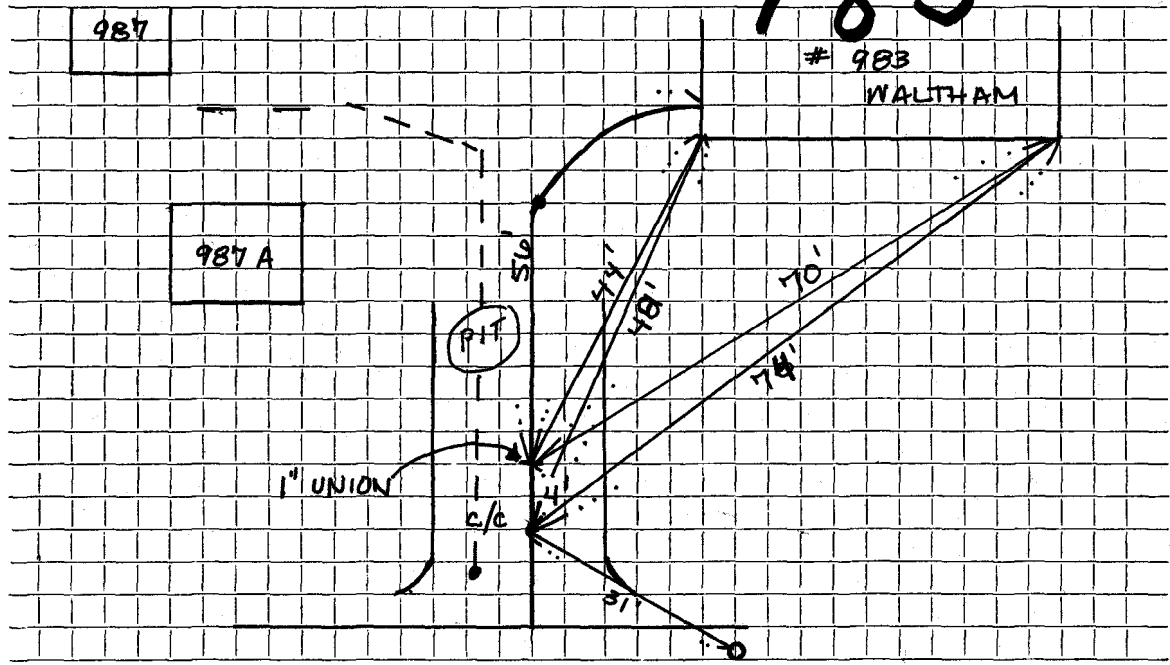

Connection made in .... WALTHAM ..... Street. Work completed .....

Remarks: INSPECTED: P.A. BARROWS  
CONTRACTOR: KIRKLAND & SHAW  
PIT FOR 987 - 987A