

WATER SERVICE RECORD

Name

Service No

Address

990 Waltham Street

Location

Repair—Renewal—New Service

J J O'Brien & Town

Date		Material	Amount	Total	Date	Amount
11/8/88	1'8"	1" Copper				
	1	1" M x Comp				
	1	2" x 1" Reducer				
	1	2" x 6" Nipple C.L.				
	1	4" x 2" End Cap			11/8/88	50'6" 1" Copper
						OUTSIDE
					1	1" Corp
					1	1" Comp Curb
					1	Roadway Box


DATE _____

TOWN OF LEXINGTON — BOARD OF PUBLIC WORKS

WATER DIVISION

990

Sketch of Service Here

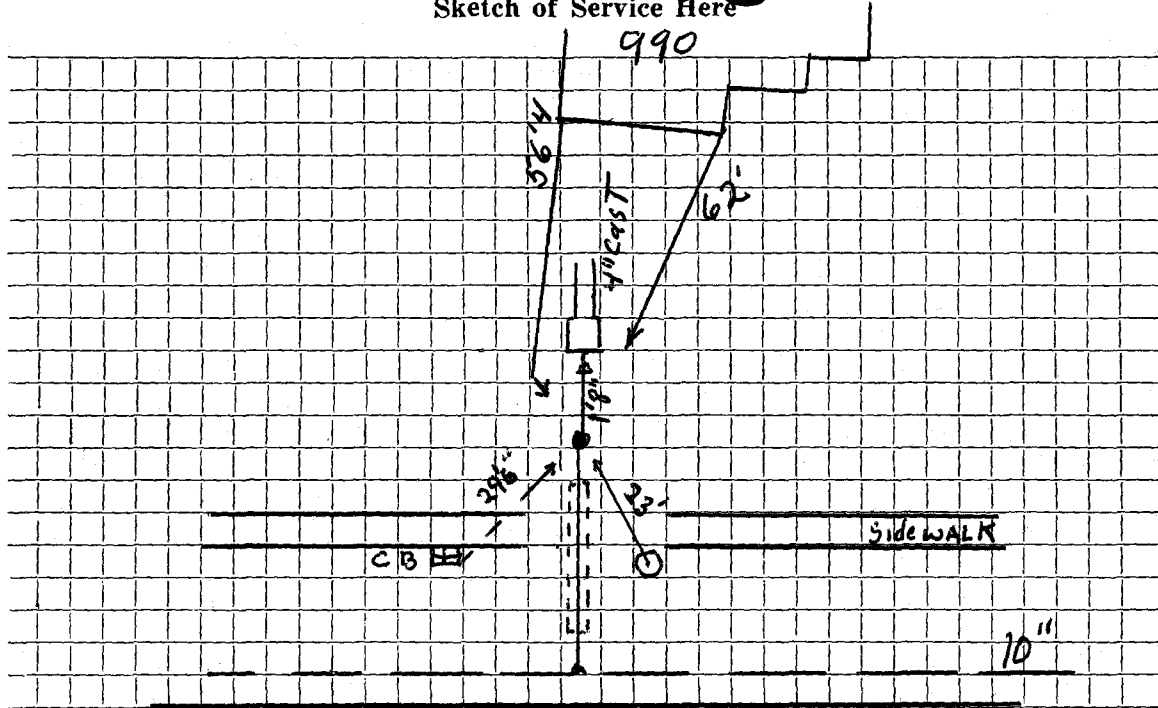

Connection made in Street. Work completed

Remarks: 1" Copper Through 4" Cast in St