

Garden service

DATE *July 22, 1929*

TOWN OF LEXINGTON—BOARD OF PUBLIC WORKS

WATER DIVISION

Liberty Farm

The undersigned applies for a supply of water at No. *Waltham* St. and hereby agrees to comply with the rules and regulations as now, or at any future time, established by the Board of Selectmen.

Am't. of Estimate \$ _____

Owner


Antonio Larra

Am't. Paid \$ _____

Address

Builder _____

Sketch of Service Here

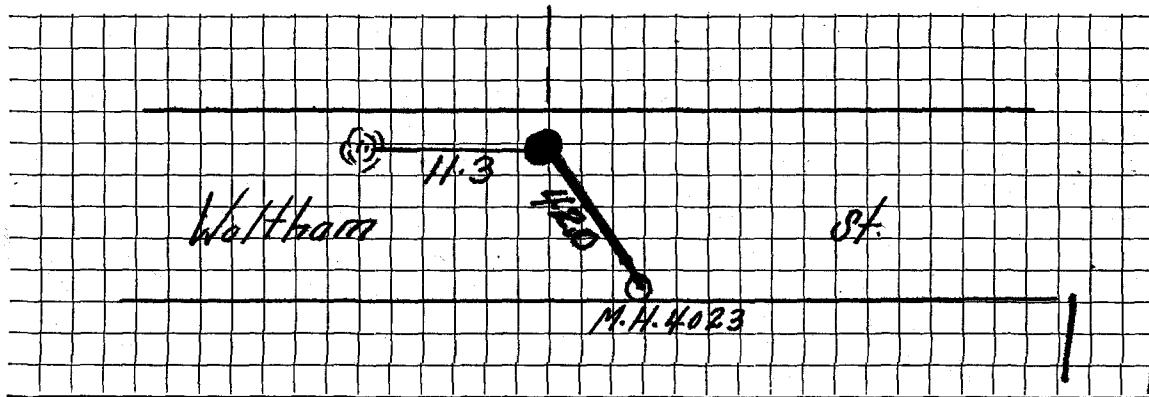

Connection made in _____ Street.

Work completed _____ '19

Remarks: