

WATER SERVICE RECORD

Name Sally T. Neale

Service No. 44

Address 10 Ward Street

Location

~~Renewal~~—Renewal—~~NEWSBERRY~~ W.O.#340

MAR 14 1966


Date		Material	Amount		Total		Date			Amount	
5/27/65		Labor	52	93				<u>CURB TO MAIN</u>			
		10% O.H.	5	29	58	22	5/27/65	Labor	15.73		
	37'	3/4" copper tubing @.42			15	54		10% O.H.	<u>1.57</u>	17	30
	3	Yds. Loam @ 3.00			9	00		11'	3/4" cop. tub.@.42	4	62
	1	3/4" x 1/2 W.H. Stop			9	29		1'	3/4" Corp. Adapter	7	41
	1	Hr. Town Truck			3	00		1	3/4" Curb	8	76
	2	Hrs. Shovel @ 6.50			13	00		1	1/2" offset		93
					108	05		1	1/2" tailpiece		93
								1	Box & Rod	4	90
										44	85
							5-21-65	Deposit		125	00
							3-14-66	Returned		16	85
										108	05

DATE _____

TOWN OF LEXINGTON — BOARD OF PUBLIC WORKS

WATER DIVISION

Sketch of Service Here

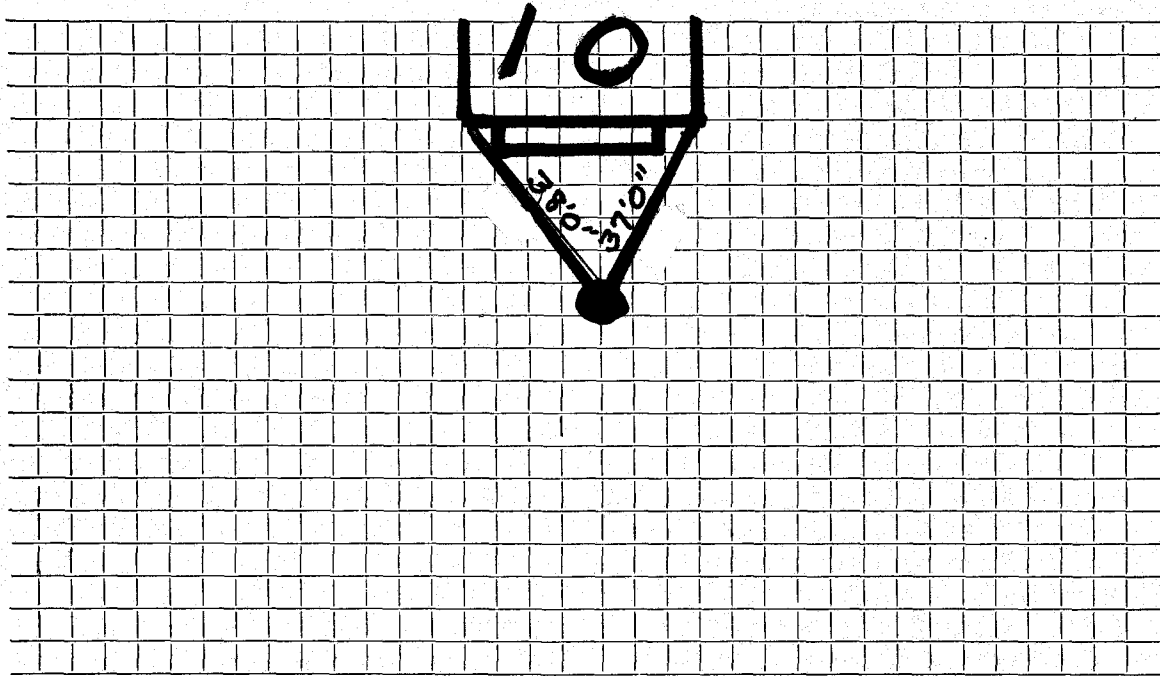

Connection made in Street. Work completed

Remarks:
.....
.....