

Name Robert Williams

4767 & 4768
Service No. 278Address ~~9 Short Street~~ Now 19 Ward

Lexington, Mass.

Locatio ~~9 Short Street~~

Kind of Pipe

Size

Size of Main

~~Repair Service~~—New Service

Com. 1166-50

Location

Date	Material	Amount	Total	Date	Amount
Sept. 2, '50	Labor	1 50	1 50	Aug 29 '50	20 00
	10% Overhead		15		
	30' - 3/4" Copper Tubing @.275		8 25		No Charge
	1 - 3/4" C x 1/2" I.W.H. S&W		3 29	Sept. 2, '50	6 00
	Littlefield Shovel 1/2 hr. @ 7.00		3 50	40' - 3/4" Copper Tubing @.275	11 00
	Trucking 1 hr. @.75		75	1 - 3/4" C Corp-cock	3 15
			17 44	1 - 3/4" C x 3/4" C Curb-cock	3 85
				1 - Box & Rod	3 35
				1 - 1/2" Offset Tail Piece	42
				1 - 1/2" Straight Tail Piece	42
				Littlefield Shovel 1 1/2 hrs. @7.00	10 50
				Trucking 1 hr. @.75	75
	Labor				39 44

DATE _____

TOWN OF LEXINGTON—BOARD OF PUBLIC WORKS

WATER DIVISION

The undersigned applies for a supply of water at No. _____ St. and hereby agrees to comply with the rules and regulations as now, or at any future time, established by the Board of Selectmen.

Am't. of Estimate \$ _____


Owner _____

Am't. Paid \$ _____

Address _____

Builder _____

Sketch of Service Here

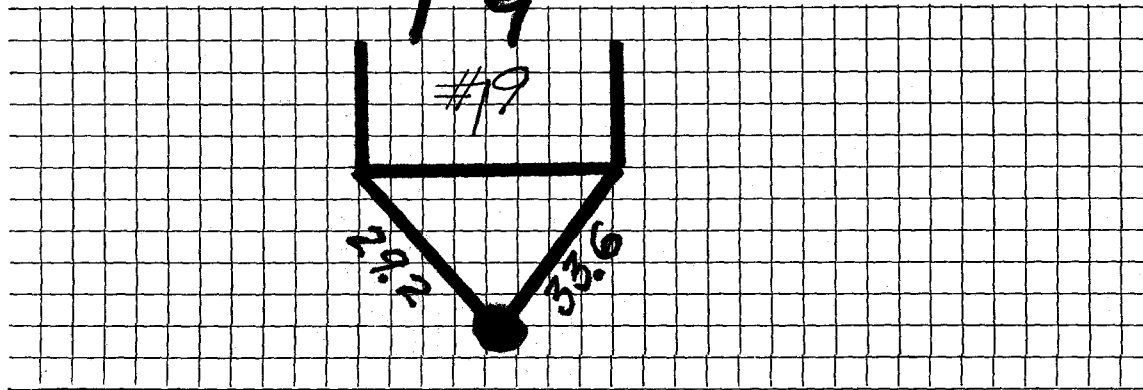

Connection made in _____ Street.

Work completed _____ 19

Remarks: