


DATE _____

TOWN OF LEXINGTON — BOARD OF PUBLIC WORKS

WATER DIVISION

Sketch of Service Here

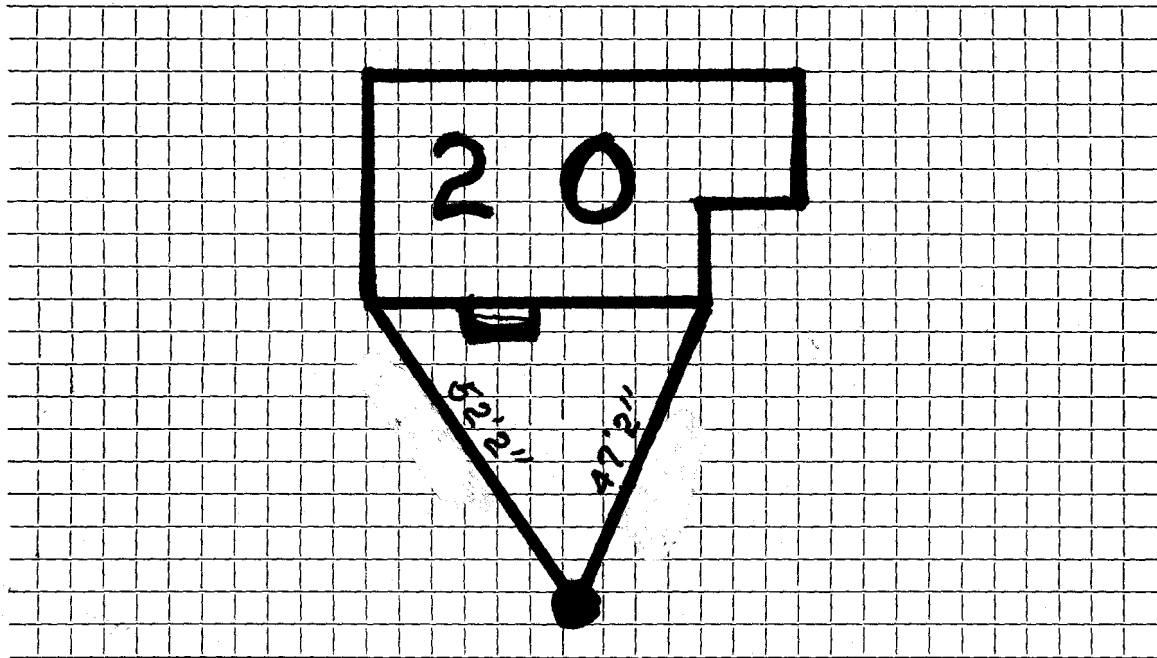

Connection made in Street.. Work completed

Remarks: ... *Old service, iron pipe - New T.E.*
.....
.....