


Water Service Tie Card
TOWN OF LEXINGTON
 MASSACHUSETTS

28 Ward St

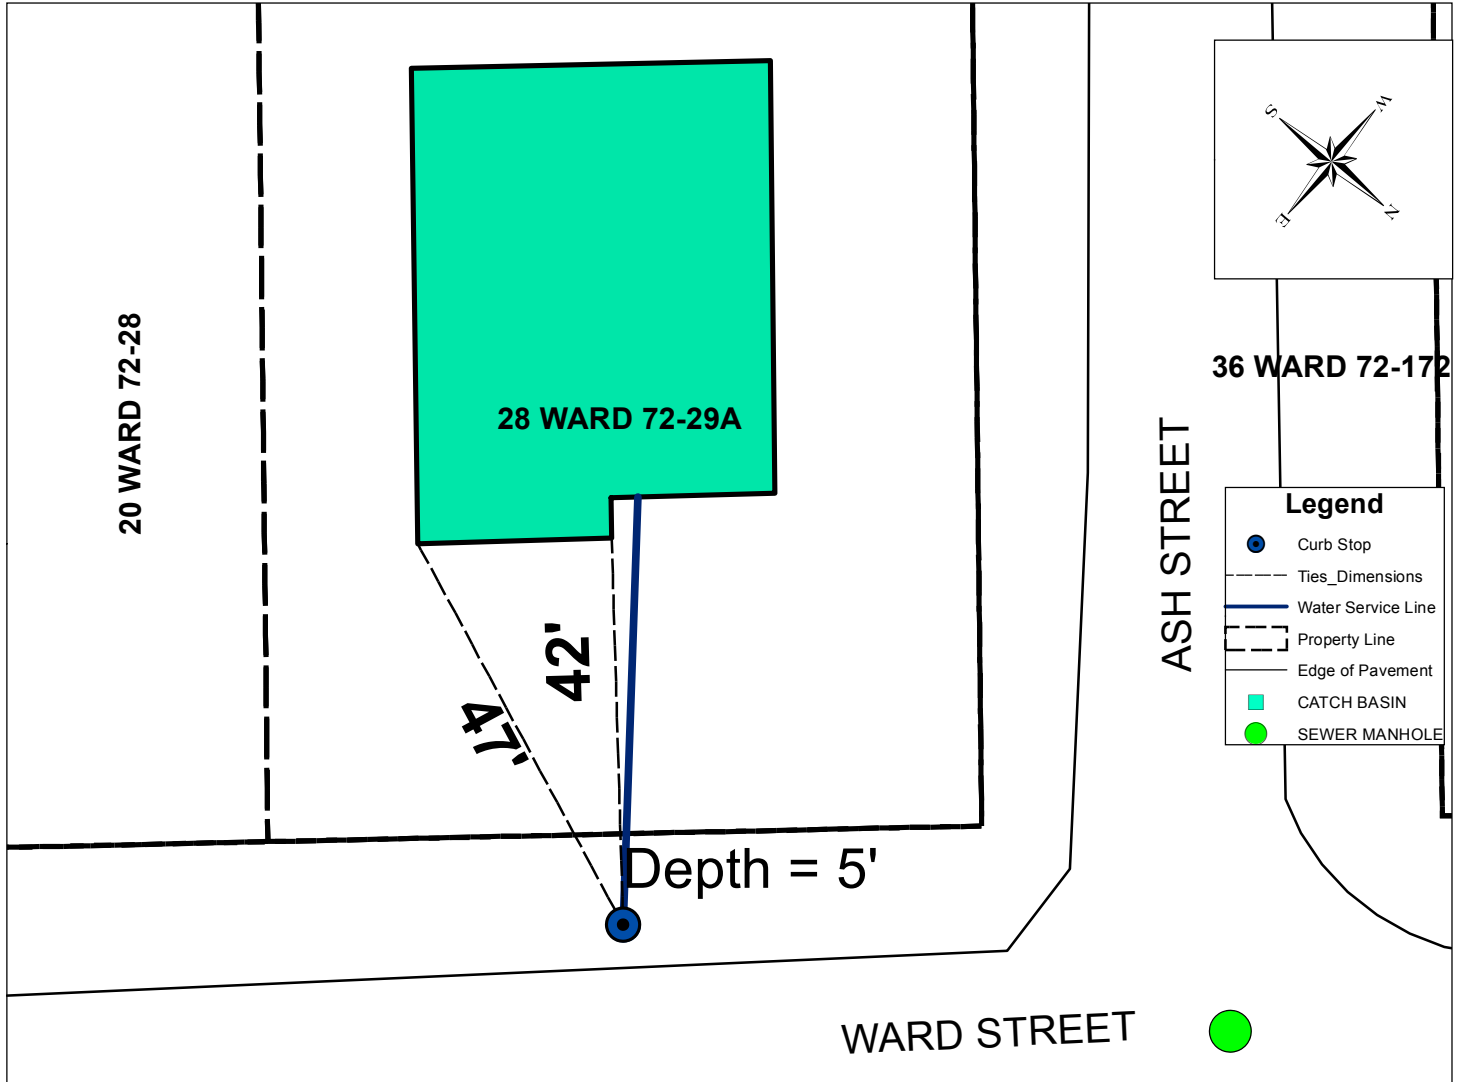

Address	Map and Lot	Permit Number	Contractor Name	Inspector
28 Ward St	72-29A	6037	Eycon Construction	msprague
Date	Material	Depth of Cover	Amount	
12/22/2014	1" Copper type "k"	5 ft	6"	
	1" Curb Valve and Buffalo Box	5 ft	1	
	1" Copper type "k"	4.5 ft	50 ft to HSE	
Type of work completed				

New 1" water service to house from curb stop. New house on lot old house removed.