

WATER SERVICE RECORD

Name

Service No.

Address

Location 36 WARD ST

Repair—Renewal—New Service REDMOND CNT


Date	Material	Amount	Total	Date	Amount
4-10-95	64' - 1" COPPER 1" VALVE			OUT	
				1" COPPER	
				1" CURB	
				1" COPP	
				BOX + ROD	

DATE \_\_\_\_\_

TOWN OF LEXINGTON — BOARD OF PUBLIC WORKS

WATER DIVISION

Sketch of Service Here

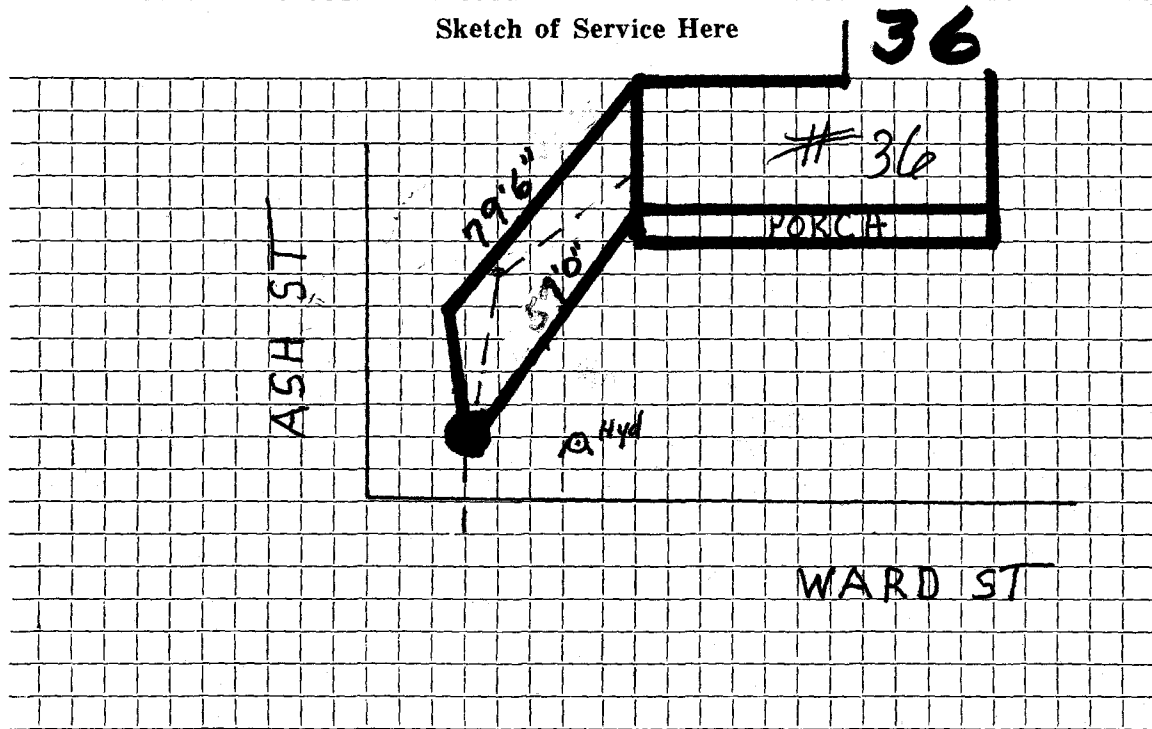

Connection made in ..... Street. Work completed .....

Remarks: .....

.....

.....