

Mr. John Fleming

Service No. ~~43~~ 2900

Address 37 Ward Street

#5278

Location

Kind of Pipe

Size

Size of Main

~~Repair - Renewal - New Service~~ New Service

Location

Date

Material

Amount

Total

Date

Amount

1/6/33

Installing service,

as per estimate

\$4 70

Jan 4 1933 - Cash

4 70

Com. 3-28-33
for
4.70

7 Hrs. Labor @.55

3 " " @.60

1 S & W

1 3/4" C. Bend.

Trench by owner, also stock

Labor

Hadley Press, Inc., Lexington

DATE January 4, 19

TOWN OF LEXINGTON—BOARD OF PUBLIC WORKS

WATER DIVISION

The undersigned applies for a supply of water at No. 38 Ward St. St. and hereby agrees to comply with the rules and regulations as now, or at any future time, established by the Board of Selectmen.

Am't. of Estimate \$ 470

Owner

John Fleming


Am't. Paid \$ 470

Address

Ward Street

Builder _____

Sketch of Service Here

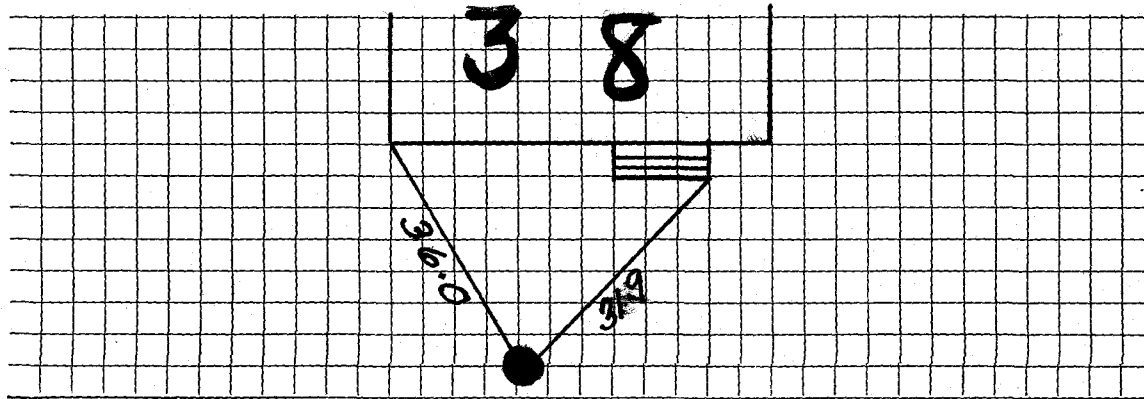

Connection made in _____ Street.

Work completed _____ 19

Remarks: