

WATER SERVICE RECORD

Name Alvaro Fernandes

1146
Service No. 9

Address 4 Ward Street

Location

~~Repair~~ - Renewal - ~~New Service~~ #6502

AUG 5 1968


Date	Material	Amount	Total	Date	Amount
4/23/68	Labor	11 97		4-15-68	100 00
	10% O.H.	1 20	13 17	8-5-68	41 17
54'	6" copper pipe @ .79		42 66		58 83
1	hr. trucking		3 00		
	TOTAL COST		58 83	4/23/68	
					MAIN TO CURB
					Labor
				21'	3/4" Copper tubing .79
				1	3/4" W.H. Stop & Waste
				1	3/4" Curb Cock
				1	3/4" Adapter
				2	hrs. Shovel @6.50
					75.91

DATE _____

TOWN OF LEXINGTON — BOARD OF PUBLIC WORKS

WATER DIVISION

Sketch of Service Here

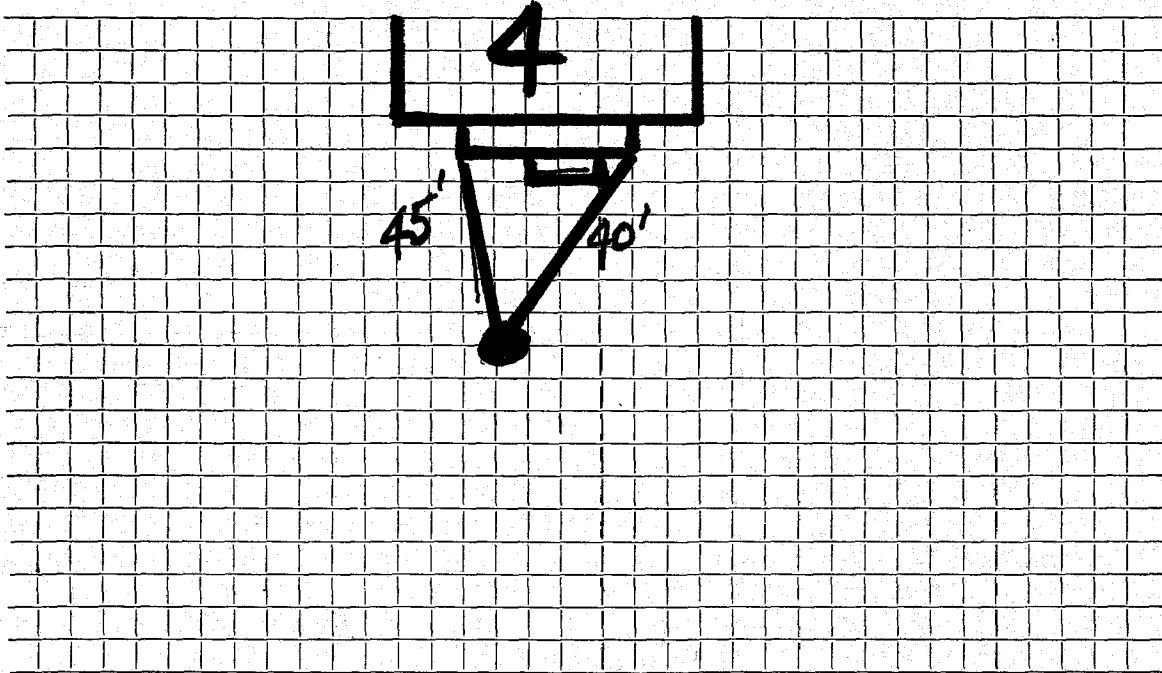

Connection made in Street. Work completed

Remarks:

.....
.....