

WATER SERVICE RECORD

Name Harold S. Pierce  
~~XXXXXXXXXXXX~~

Service No. 86

Address 42 Ward Street

Location

~~XXXXXXXXXXXX~~ <sup>Renewed</sup> ~~XXXXXXXXXXXX~~ W.O. #8143


Comm 10-28-63

Date		Material	Amount	Total	Date		Amount
9-5-63		Labor	39 53		8-26-63	Deposit	160 00
		10% O.H.	3 95	43 48	10-28-63	Refund	45 25
55'		3/4" Copper tubing @.42		23 10			104 25
1		3/4" CX 1/2 I.W.H. Stop & Waste		6 17			
3		Yards Loam @3.00		9 00		NON CHARGE	
3		Hrs. Town Shovel @6.50		19 50	9-5-63	1 1/2 Straight tailpiece	50
1		Hr. Trucking @3.00		3 00		1 1/2 Offset Tailpiece	50
				104 25			1 00
					9/16/55	5' - 3/4 COPPER	
						1 3/4 CURB STOP	
						1 3/4 COPP	
						Box + Rod	

TOWN OF LEXINGTON — BOARD OF PUBLIC WORKS

WATER DIVISION

Sketch of Service Here

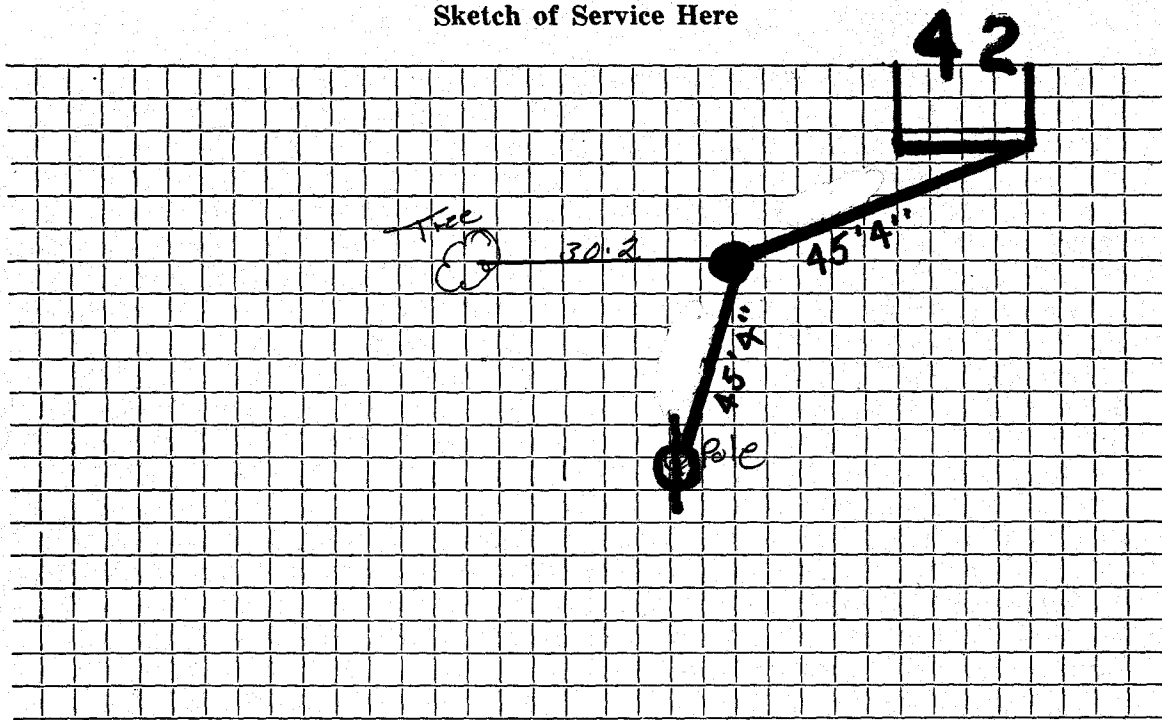

Connection made in ..... Street. Work completed .....

Remarks: .....

.....

.....