

WATER SERVICE RECORD

Name Albert C. Cuccinello

Service No. 199

Address 45 Ward Street

#3802

Location

~~Repair~~ ~~Renewal~~ ~~New Service~~

Comm. 11-18-57

Date	Material	Amount	Total	Date	Amount	
9/12/57	Labor	3 25		9-12-57	Deposit	\$ 50 00
	10% overhead	33	3 58	11-18-57	Refund *	2 55
	65' - 1" Copper tubing @ .5202		33 81		NON CHARGE	\$ 47 45
	1 - 1" Cx1" I.W.H. Stop & Waste		5 60	29' - 1" Copper tubing @ .5202		12.48
	1 hr. trucking		75	1 - 1" Corp Cock		5 61
	1 - 1" C. Union (3 part)		3 12	1 - 1" Curb Cock		6 49
	1 1"x3/4" Bushing		59	1 Box & Rod		4 62
			47 45	1 - 3/4" Straight tailpiece		50
				1 - 3/4" Offset tailpiece		50
						33 38


* Applied to S.N.C. # 151

DATE _____

TOWN OF LEXINGTON — BOARD OF PUBLIC WORKS

WATER DIVISION

Sketch of Service Here

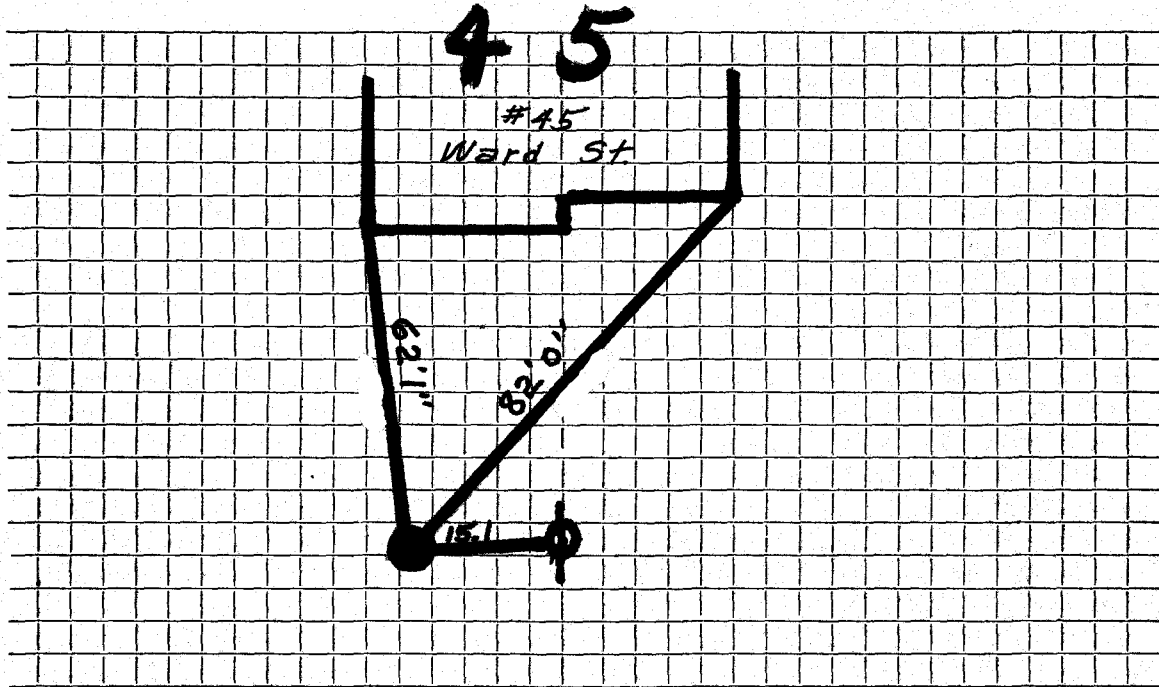

Connection made in Street. Work completed

Remarks:

.....

.....