




DATE 7/31/2019

TOWN OF LEXINGTON — BOARD OF PUBLIC WORKS

WATER DIVISION

Sketch of Service Here

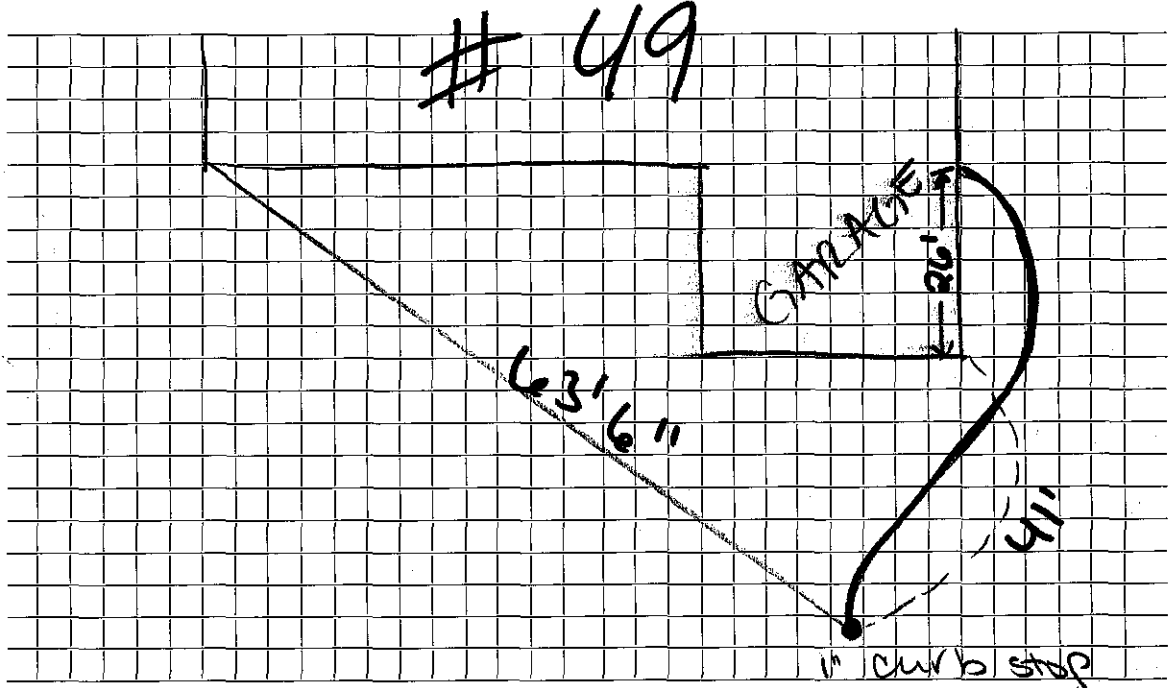

Connection made in Ward Street. Work completed .....

Remarks: total run of water = 68'