

Name Simon Stone

Service No. 67 2902 <sup>607</sup>

Address 51 Ward Street

Lexington, Mass.

Location 51 Ward Street

Kind of Pipe

Size

Size of Main

~~Repair—Renewal—New Service~~

Location

Date	Material	Amount	Total	Date	Location	Amount
Aug. 12, '46	Labor	19 64	19 64	Aug 6, '46	Deposited	40 00
	10% Overhead		1 96	Nov 29 '46	Refunded	8 21
	32' - $\frac{3}{4}$ " Copper Tubing @.1911		6 12		Non-Charge	31 79
	1 - $\frac{3}{4}$ " C x $\frac{3}{4}$ " I.W.H. Stop & Waste		2 82	Aug. 10, '46	Labor	19 00
	1 - $\frac{3}{4}$ " Close Nipple		35	28' - $\frac{10}{16}$ " Copper Tubing @.1911		5 35
	1 - $\frac{1}{4}$ " x $\frac{1}{2}$ " Elbow		15	1 - $\frac{3}{4}$ " C x $\frac{3}{4}$ " C Curb-cock		3 30
	Trucking 1 hr. @.75		75	1 - $\frac{3}{4}$ " C Adapter		1 18
			31 79	Patching 21 x 3		21 00
				Comprressor 2 hrs. @1.75		3 50
				Trucking 1 hr. @.75		75
						57 08
	<b>Labor</b>					

Hadley Press, Inc., Lexington

DATE \_\_\_\_\_

# TOWN OF LEXINGTON—BOARD OF PUBLIC WORKS

## WATER DIVISION

The undersigned applies for a supply of water at No. \_\_\_\_\_ St. and hereby agrees to comply with the rules and regulations as now, or at any future time, established by the Board of Selectmen.


Am't. of Estimate \$ \_\_\_\_\_

Owner \_\_\_\_\_

Am't. Paid \$ \_\_\_\_\_

Address \_\_\_\_\_

Builder \_\_\_\_\_

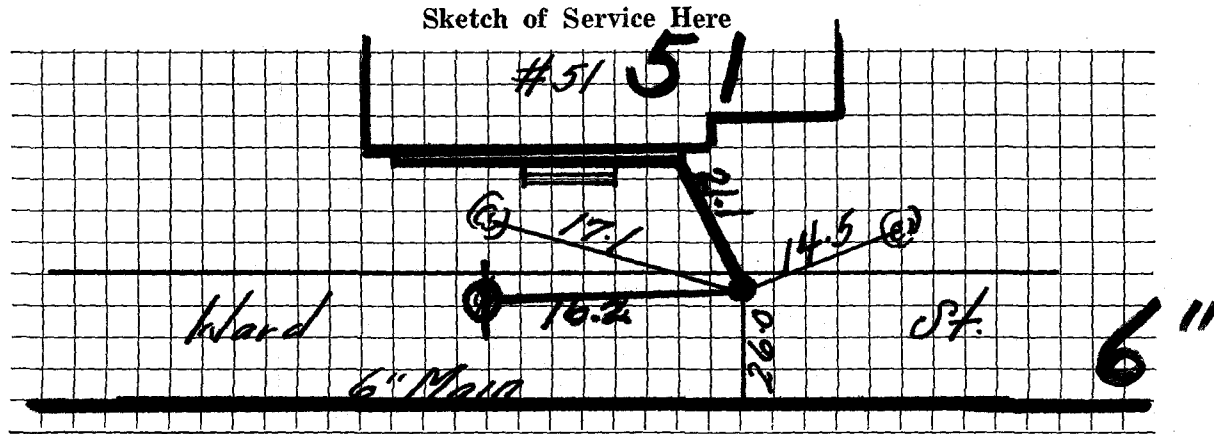

Connection made in \_\_\_\_\_ Street.

Work completed \_\_\_\_\_ 19

Remarks: