

WATER SERVICE RECORD

Name Gordon Osgood

Service No. 19

Address 52 Ward Street

Location

Repair—Renewal—New Service

OCT 4 1971


Date	Material	Amount	Total	Date	Amount
7/21/71	Labor		7 41	7-21-71	100 00
	10% O.H.		74	10-4-71	50 06
20'	3/4" Copper pipe	.79	15 80		49 94
1	3/4" Corporation		9 57		
1	3/4" Curb cock		11 32		
1	Box & Rod		<u>5 10</u>		
			49 94		

DATE _____

TOWN OF LEXINGTON -- BOARD OF PUBLIC WORKS

WATER DIVISION

Sketch of Service Here

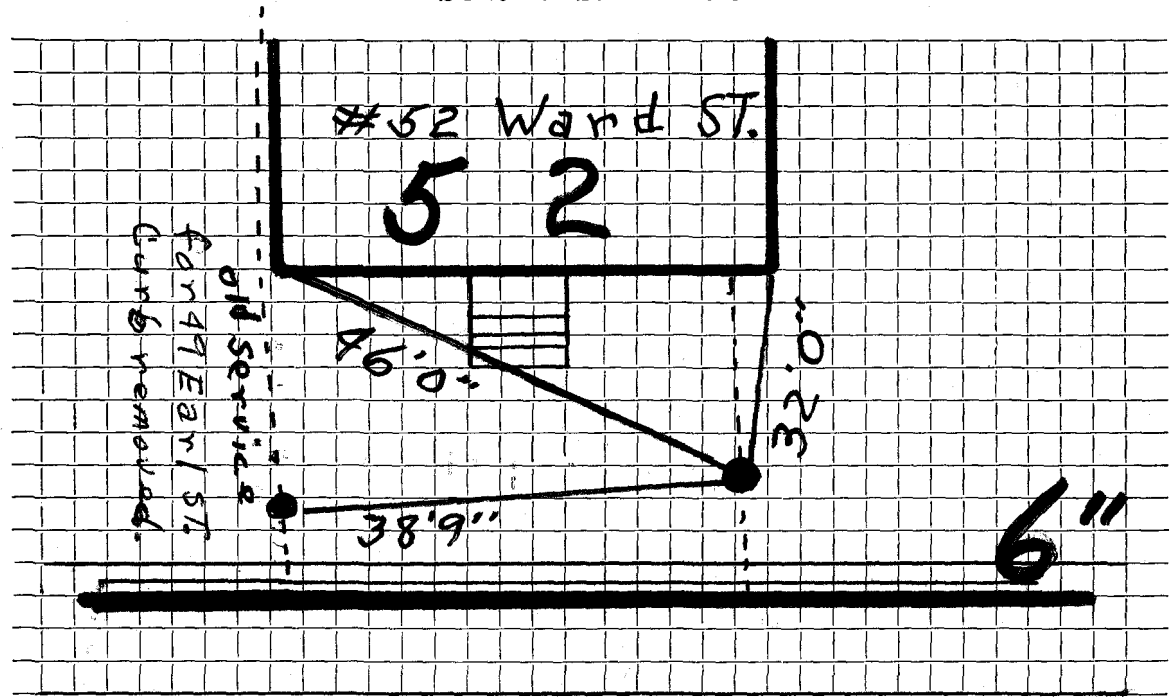

Connection made in Street. Work completed

Remarks: *Old service for 99 Earl St. shut off & disconnected at main but copper still in ground - No curb box - was removed 8/25/92*