

WATER SERVICE RECORD

Name **Kenneth P. Kelley, Jr.**Service No. **25**Address **54 Ward St.**

Location

~~Repair Renewal~~—New Service **W.O. #6538** DeFlice #1415**SEP 2 1969**


Date	Material	Amount	Total	Date	Amount
7/7/69	Labor	5 97		6-19-69	75 00
	10% O.H.	60	6 57	7-5-69	55 12
	13' 3/4" Copper tubing .79		10 27		39 88
	1 3/4" Corp. Cock		9 57		
	1 3/4" Curb Cock		8 37		
	1 Box & Rod		5 10		
			39 88		
7-18-69	38' 3/4" Copper tubing				

DATE _____

TOWN OF LEXINGTON -- BOARD OF PUBLIC WORKS

WATER DIVISION

Sketch of Service Here

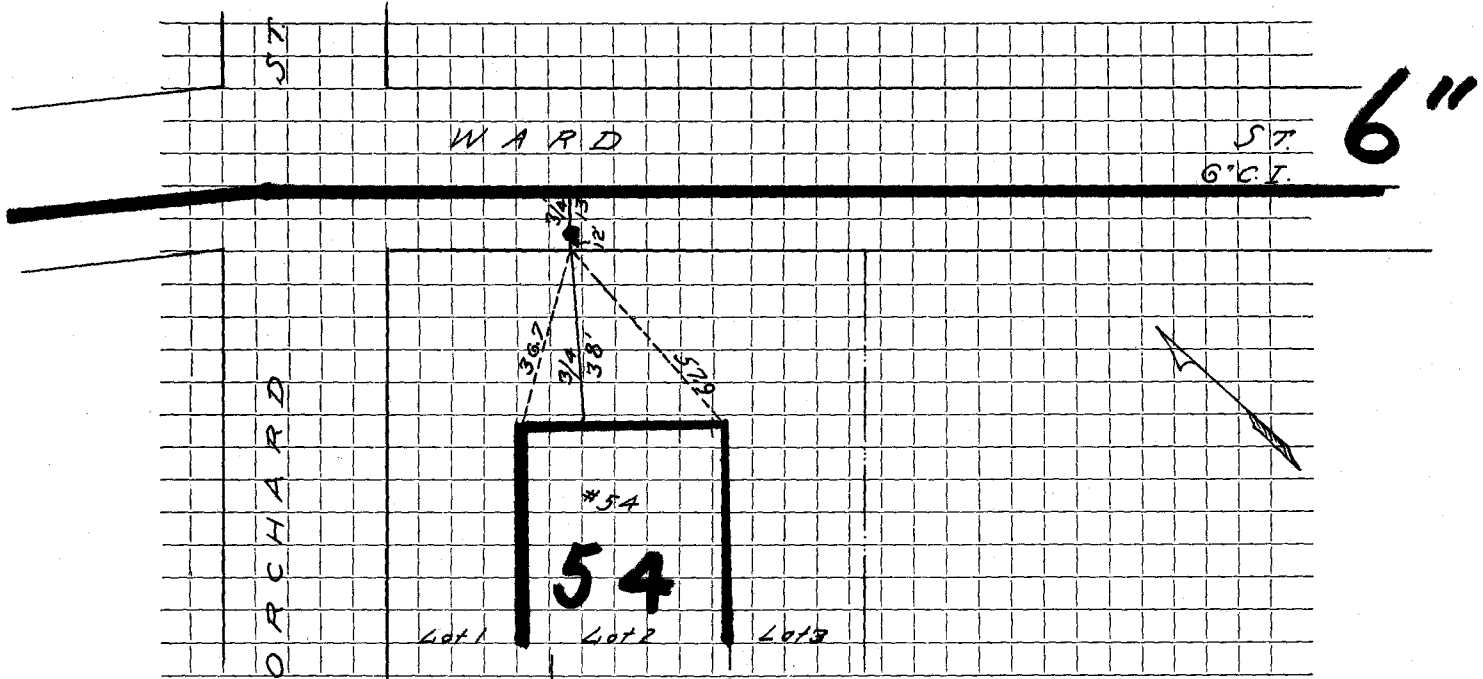

Connection made in Street. Work completed

Remarks:

.....

.....