


TOWN OF LEXINGTON - BOARD OF PUBLIC WORKS
WATER DIVISION

Date: June, 2021

SKETCH OF SERVICE HERE
59 Ward St

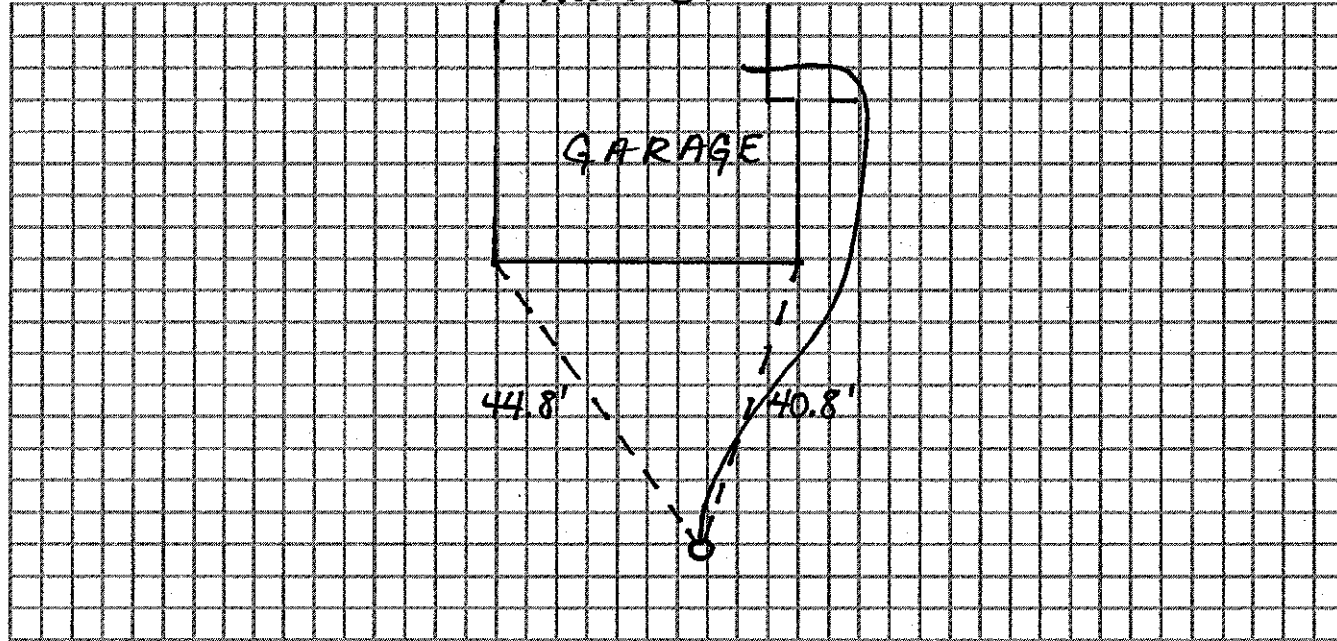

Connection made in:

Street:

Work completed:

Remarks: Installed by Bradley Landscaping