




DATE 10-31-2001

TOWN OF LEXINGTON — BOARD OF PUBLIC WORKS

WATER DIVISION

Sketch of Service Here

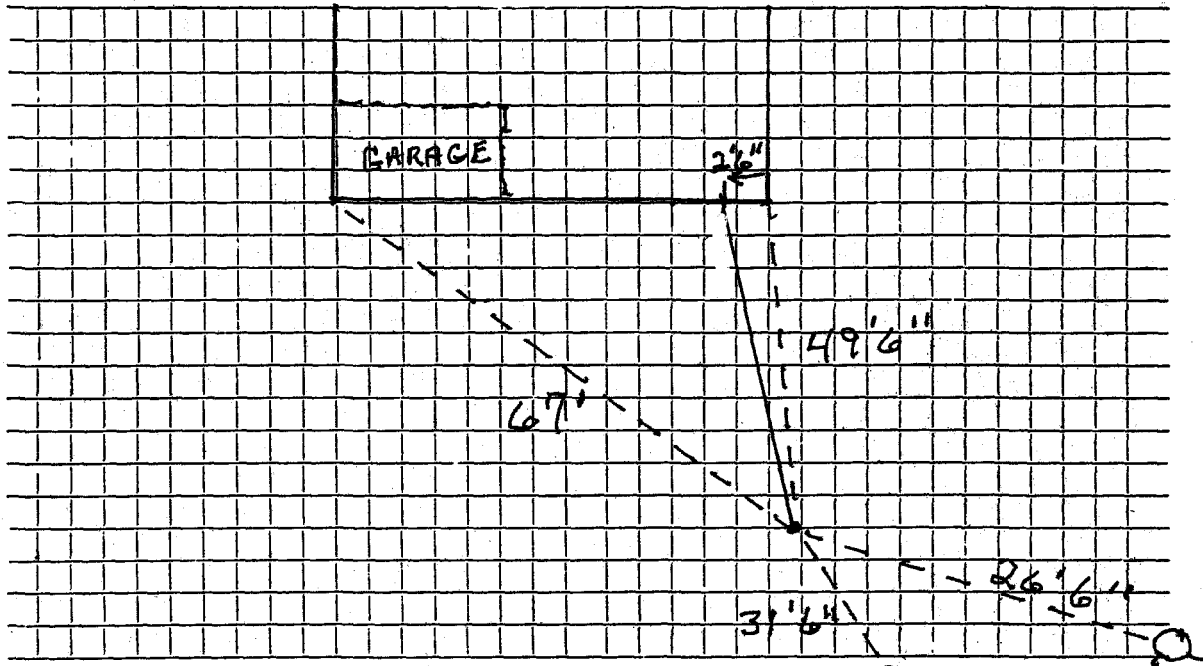

Connection made in WARD Street. Work completed

Remarks: INSTALLED by J. McLAUGHLIN