

Name George W. Ryan

Service No. ~~62~~ 2906

Address 68 Ward Street

#2749

Location

Kind of Pipe

Size

Size of Main

Repair—Renewal—New Service

Location

Date
1937

Material

Amount

Total

Date

Amount

8/10

2 hrs. @ 65¢

1 30

January 3, 1938 Paid

10

10 1/2 " @ 60¢

6 30

3 " @ 55¢

1 65

9 25

10% overhead

92

9' 3/4" Cop. Tubing @ 25¢

2 25

1 3/4" C. Corp. Cock

2 25

1 3/4" C. Curb cock

4 00

1 hr. trucking @ 75¢

75

Trench Repairs

5 56

Bill sent 7/3/37
" " 12/18/37

24 98

Flat Rate:

Charge \$10.00

10 00

Labor

Hadley Press, Inc., Lexington

DATE 8/16/37

TOWN OF LEXINGTON—BOARD OF PUBLIC WORKS

WATER DIVISION

The undersigned applies for a supply of water at No. Ward St. and hereby agrees to comply with the rules and regulations as now, or at any future time, established by the Board of Selectmen.

Am't. of Estimate \$ 10.00 (paid bill)


Owner George W. Ryan

Am't. Paid \$ 10.00

Address _____

Builder _____

Sketch of Service Here

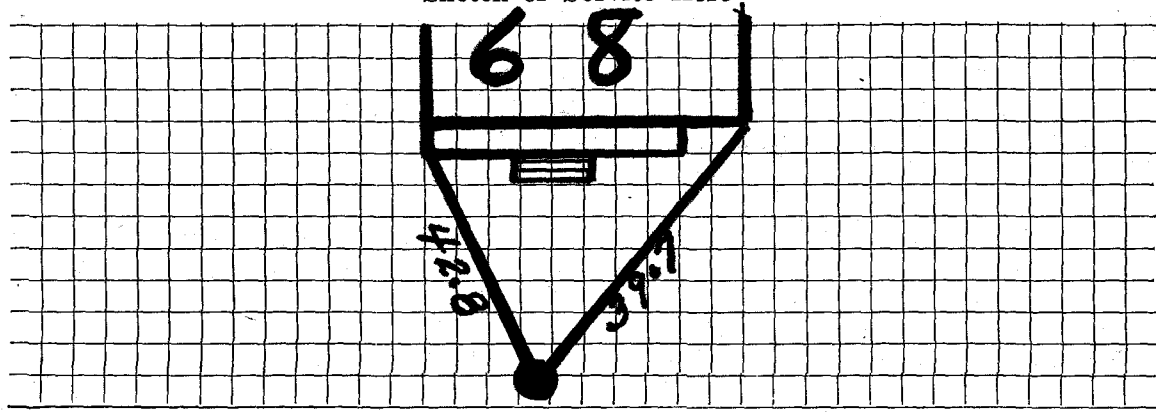

Connection made in _____ Street.

Work completed _____ 19

Remarks: