

WATER SERVICE RECORD

#2020

Service No. #2021

Name
Address 70 Ward Street

Location

~~Repair~~ - Renewal - ~~New Service~~ W.O. #3357


Date	Material	Amount	Total	Date	Amount
	<u>MAIN TO CURB</u>				
9-26-66	Labor <i>Outside</i>	79 20			
	10% O.H.	7 92	82 12		
					<i>Inside</i>
9'	3/4" copper tubing @ .79		7 11	9-13-43	
1	3/4" corp. Cock		7 42	40'	1" C.L. Pipe
1	3/4" curb cock		8 76		1 1" X 1" l.w.h. Stop + Waste
1	1" coupling		2 81		1 1" L.L. UNION
1	Box & Rod		5 10		1 1" L.L. Elbow
5	Hrs. Trucking @ 3.00		15 00		2 1" Brass Close Nipple
4	Hr. Tractor @ 6.50		26 00		1 1" X 1/2" L.L. Elbow
			159 32		
				8-9-01	37' - 1" Copper

DATE _____

TOWN OF LEXINGTON — BOARD OF PUBLIC WORKS

WATER DIVISION

Sketch of Service Here

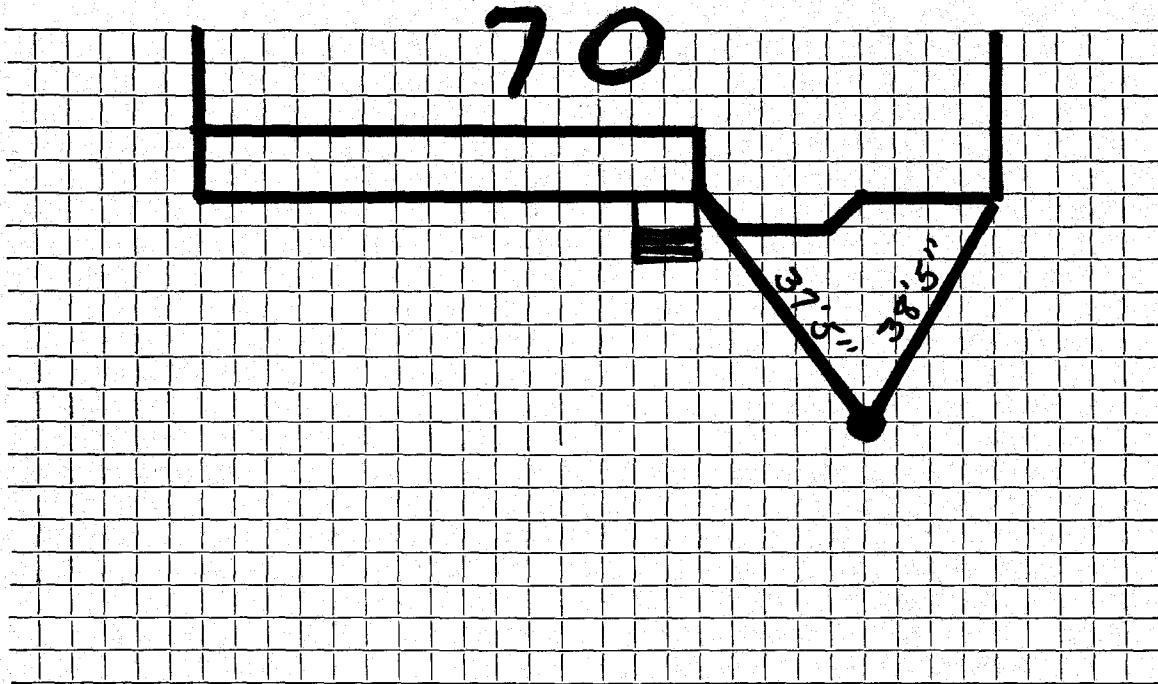

Connection made in Street. Work completed

Remarks:
.....
.....