

Name Alfred Jackson

Service No.

4/6 2750

Address 74 Ward Street

Lexington, Mass.

Location 74 Ward Street

Kind of Pipe

Size

Size of Main

~~RENEWAL~~—Renewal—~~NEW SERVICE~~

Com. 5-2-49

Location

Date	Material	Amount	Total	Date	Amount
Apr. 12, '49	Labor	1 25	1 25	Apr. 15 '49	20 00
	10% Overhead		13	May 5 '49	3 56
	36' - 3/4" Copper Tubing @.27	9 72			16 44
	1 - 3/4" C x 3/4" I.W.H. S&W	3 29		Apr. 11, '49	2 20
	1 - 3/4" C x 3/4" I Union 2 pts	88			
	1 - 3/4" Close Nipple		42		
	Trucking 1 hr. @.75		75		
			16 1/4		
	Labor				

Deposited
 Refunded
 Non-Charge

DATE _____

TOWN OF LEXINGTON - BOARD OF PUBLIC WORKS

WATER DIVISION

The undersigned applies for a supply of water at No..... St. and hereby agrees to comply with the rules and regulations as now, or at any future time, established by the Board of Selectmen.

Am't of Estimate \$.....

Owner


Am't Paid \$.....

Address

Builder

.....

Sketch of Service Here

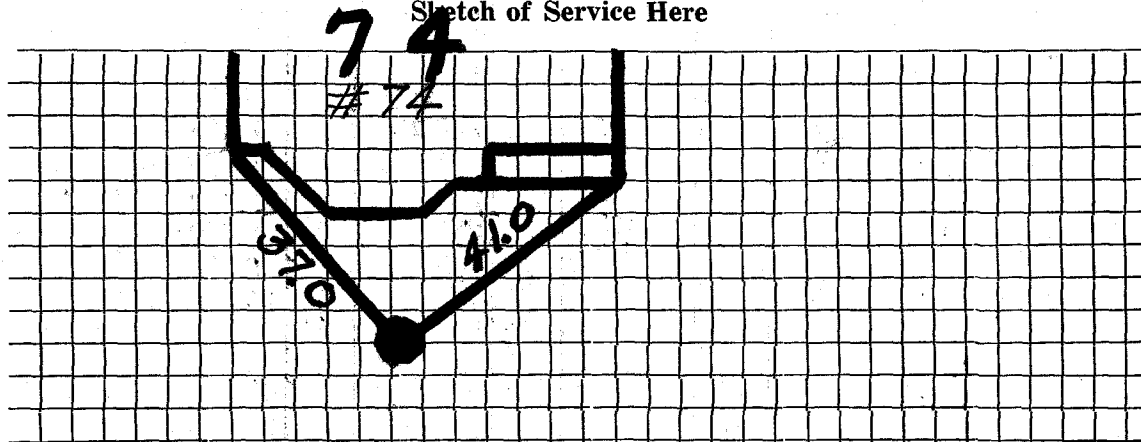

Connection made in Street.

Work completed19

Remarks: