

WATER SERVICE RECORD

1403

Name S. Casella

Service No. 150

Address 79 Ward Street

Location Lexington, Mass.

~~REPAIRS~~ - New Service

*Com. 9-24-51*


Date	Material	Amount	Total	Date	Amount
7/26/51	Labor	1 49	1 49	7-6-51 Deposited	45 00
	10% overhead		15	9-24-51 Refunded	(15 59)
	50' -3/4" copper tubing @ .326	16 30		<u>No Charge</u>	39 41
	1 -3/4" C x 1/2 I.W.H. stopwaste		4 00	7/26/51 Labor	5 72
	1 -3/4" C x 3/4" C Union (3pts.)		1 72	30' -3/4" copper tubing @ .326	9 78
	1 hr. trucking		75	1 - 3/4" C. corp-cock	4 33
	patching 15 x 3		15 00	1 - 3/4" C x 3/4" C. curb-cock	4 67
			39 41	1 box and rod	4 68
				1 -1/2 offset tail piece	50
				1 - 1/2 straight tail piece	50
				2 1/3 hrs. Littlefield shovel	16 33
				1 hr. trucking	75
					47 26

DATE \_\_\_\_\_

# TOWN OF LEXINGTON — BOARD OF PUBLIC WORKS

## WATER DIVISION

Sketch of Service Here

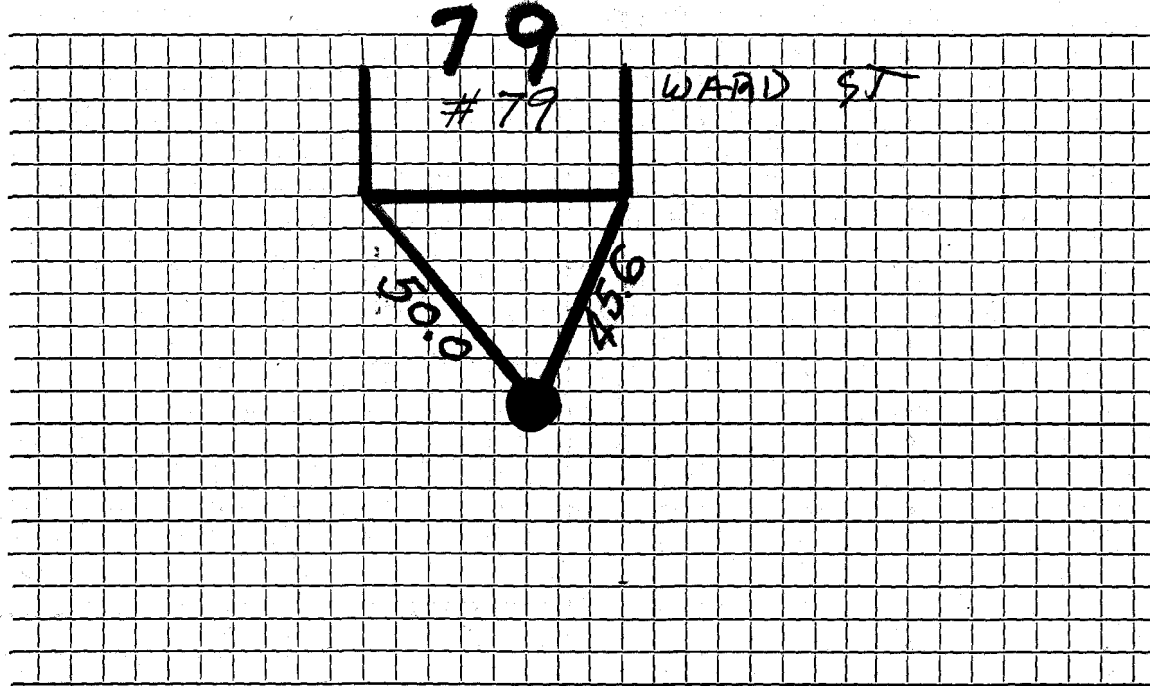

Connection made in ..... Street. Work completed .....

Remarks: .....

.....

.....