

WATER SERVICE RECORD

Name

Service No.

Address 82 Ward Street

Location

~~Repairs~~ ~~Renewals~~ ~~New Service~~

W.O. #3201

Outside Renewal


Date	Material	Amount	Total	Date	Amount	
				5-28-75	2' 3/4" Copper	
					1 1" Clamp	
					1 1" X 3/4" C. To l. FITTING	
					Outside(Non-Charge)	
				3-31-75	Labor	\$121.44
					15' 3/4" Copper Pipe @1.01	15.15
					1 3/4" Adapter	5.72
					1 3/4" Curb Cock	14.40
					1 1" Repair Clamp	5.25
					1 1" x 4" Nipple	.55
					1 1" Coupling	1.14
					1 1" x 3/4" Brass Bushing	1.72
					1/2 Ton Cold Patch	3.05
					1/2 Ton Hot Top	3.05
					2 Hrs. Trucking @3.00	6.00
					2 Hrs. Backhoe @6.50	13.00
						<u>13.00</u>
						\$190.47

DATE _____

TOWN OF LEXINGTON — BOARD OF PUBLIC WORKS

WATER DIVISION

Sketch of Service Here

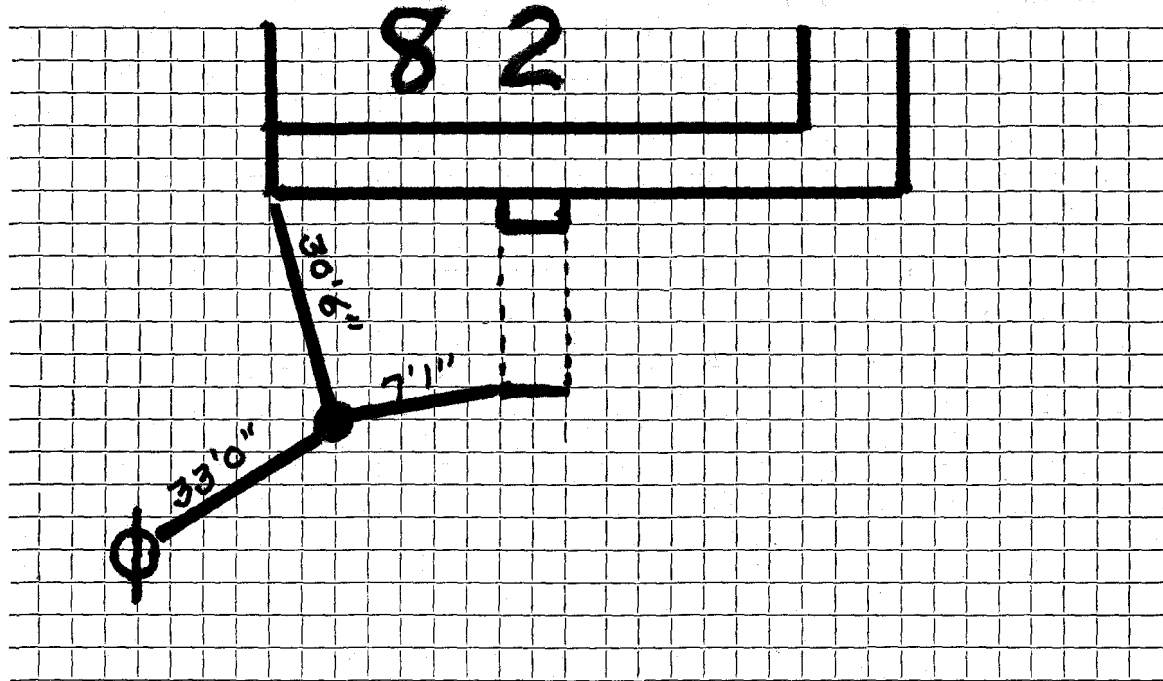

Connection made in Street. Work completed

Remarks:
.....
.....