

Name Fred Sgrosso

Service No. 68 2897

Address Ward Street (Garden)

Location

Kind of Pipe

Size

Size of Main

~~Repair~~ ~~Renewal~~ - New Service

Flat rate

Location

Date
1941

Material

Amount

Total

Date

Amount

July 7

2 hrs. @ 60¢

1 20

10% Overhead

12

1 32

18' 3/4" Copper tubing @ 19¢

3 42

1 3/4" C.x I S.& W.

2 25

1 3/4" C. Meter Stand

3 75

1 3/4" Close Nipple

35

2' 20" Clay Pipe @ 1.50

3 00

1 Pit Cover

4 10

1 hr. trucking

75

18 94

July 8, 1941 Reported

15 00

CHARGE FLAT RATE \$15.00

Labor

DATE _____

TOWN OF LEXINGTON—BOARD OF PUBLIC WORKS

WATER DIVISION

The undersigned applies for a supply of water at No. _____ St. and hereby agrees to comply with the rules and regulations as now, or at any future time, established by the Board of Selectmen.

Am't. of Estimate \$ _____


Owner _____

Am't. Paid \$ _____

Address _____

Builder _____

Sketch of Service Here

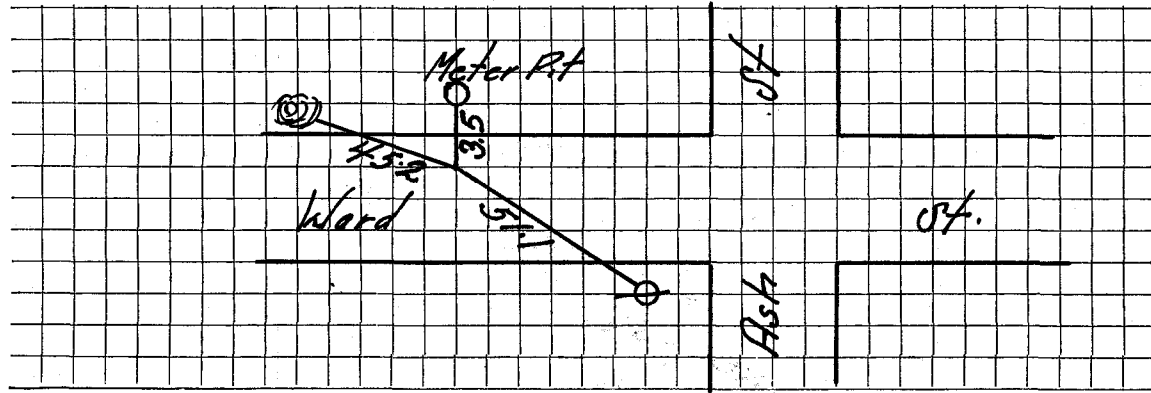

Connection made in _____ Street.

Work completed _____ 19

Remarks: