

WATER SERVICE RECORD

Service No. 288

Name Mrs. Galt Parsons

Address 12 Warren Street, Lexington, Mass.

Location

~~Repair~~ — Renewal — ~~New Service~~

Com. 11-21-55

Date	Material	Amount	Total	Date	Amount
8/15/55	Labor	35 35		8-15-55 Deposited	60 00
	10% Overhead	3 54	38 89	2-6-56 Paid	9 58
	35'-3/4" Copper tubing@.384		13 44		69 58
	1-3/4"x1/8" I.W.H. stop&waste		4 00	8/15/55 Labor	11 20
	1 hr. trucking@.75		75	11'-3/4" Copper tubing@.384	4 22
	1-2/3hrs. Littlefield Shovel@7.50		12 50	1-3/4" Adapter	1 95
			69 58	1-3/4"x3/4" Curb cock	4 67
				1-1/2" offset tail piece	50
				1-1/2" straight tail piece	50
				1/3 hr. Littlefield Shovel@7.50	2 50
					25 54


Bill sent 11-22-55

DATE \_\_\_\_\_

TOWN OF LEXINGTON — BOARD OF PUBLIC WORKS

WATER DIVISION

Sketch of Service Here

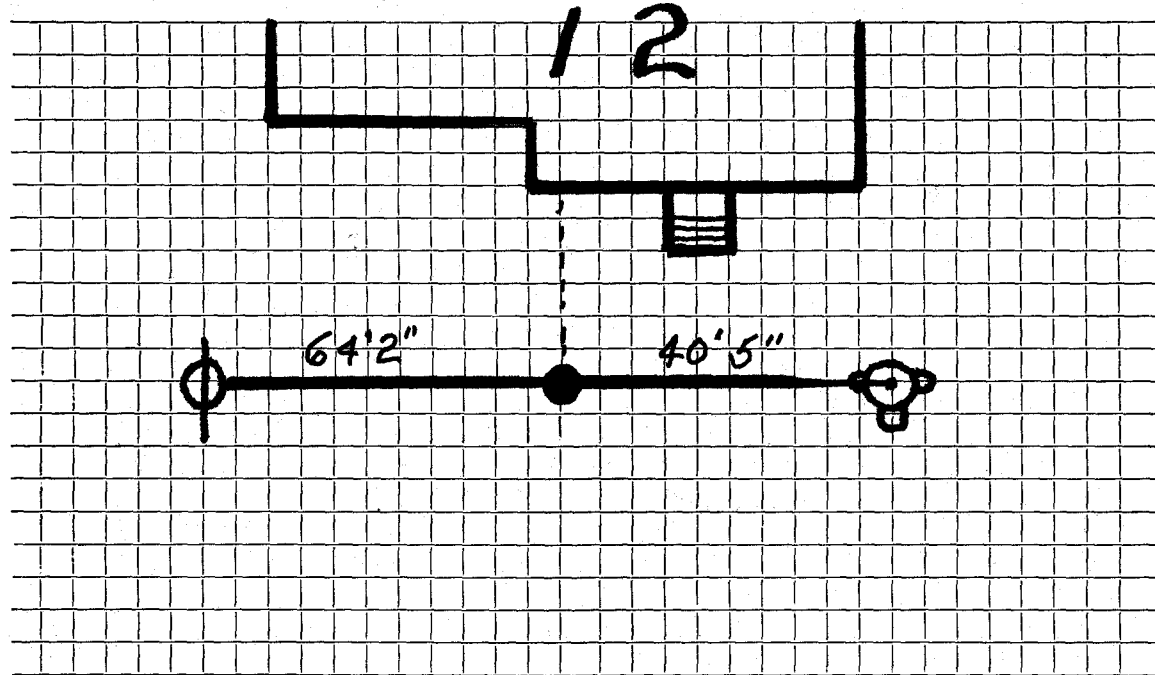

Connection made in ..... Street. Work completed .....

Remarks: .....  
.....  
.....