

Check from:

Owner: Ethel H Read

Service No. 55 2910

Name MacFawn-Barry Co.,
By-Clarence W. Barry - 16 Vaille Ave
Address 2 Warren St.

Location # 2 Warren St.
Cor. Warren & Percy Road. # 1737

Kind of Pipe Size Size of Main

~~Repair-Renewal~~ New Service

Location

| Date | Material | Amount | Total | Date | Amount |
|---------------|----------------------------|--------|-------|------------------------------|--------|
| Oct. 11, 1940 | 7½ hrs. @ 60¢ | 4 50 | | | |
| Sept 17-31-40 | 10% Overhead | 45 | 4 95 | September 16, 1940 Deposited | 25 00 |
| | 40' 3/4" Copper tub. @ 19¢ | | 7 60 | Dec 31, 1940 Refund | 1 40 |
| | 1 3/4" C.S.& W. | | 2 25 | | 23 54 |
| | 1 3/4" C Union (3 part) | | 90 | | |
| | 1 hr. trucking | | 75 | | |
| | Construction charge | | 3 75 | | |
| | Trench repairs | | 3 34 | | |
| | | | 23 54 | | |
| | Labor | | | | |

Hadley Press, Inc., Lexington

coming in from recycled.

DATE Sept. 2, 1944

TOWN OF LEXINGTON—BOARD OF PUBLIC WORKS WATER DIVISION

The undersigned applies for a supply of water at No. _____ St. and hereby agrees to comply with the rules and regulations as now, or at any future time, established by the Board of Selectmen.

Am't. of Estimate \$ 75⁰⁰


Owner Leslie Read

Am't. Paid \$ _____

Address 18 Payson Rd.
Belmont

Builder Clarence W. Barry
Dep. 0131 M

Sketch of Service Here

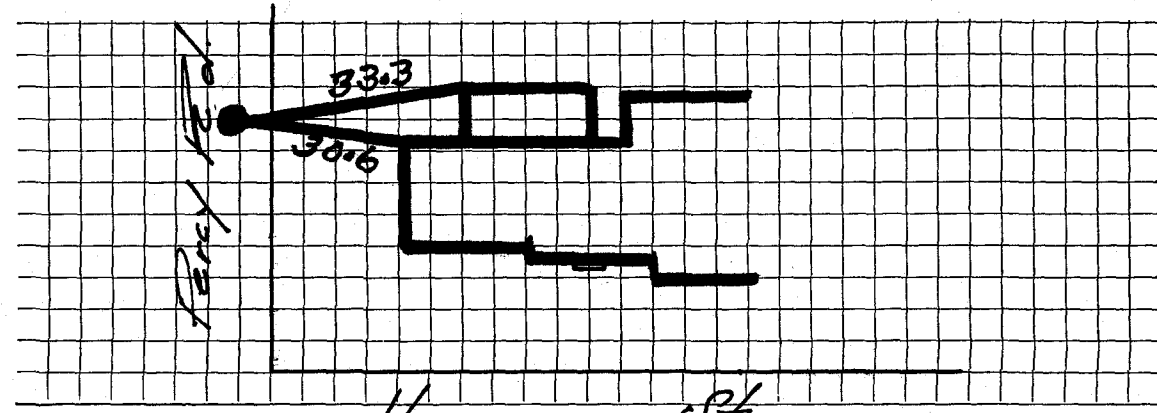

Connection made in _____ Warren St.

Work completed _____ 19

Remarks: