

8751

WATER SERVICE RECORD

5783

Name Charles F. Clerkin

Service No. 102

Address 9 Warren Street

Location

~~RENEWAL - RENEWAL~~

Comm 8-1-60


Date	Material	Amount	Total	Date	Amount
6-27-60	Labor	4 74		6-16-60	Deposit 40 00
	10% O.H.	47	5 21		Retaind 1 58
51'	1" Copper tubing @4676		23 85		38 62
1	1"x3/4" I.W.H. Stop&Waste		6 96		
2	1" Lead Lined Elbows @54		1 08		NON CHARGE
2	1" Brass Close Nipples @76		1 52		Labor 3 88
			38 62	17'	1" Copper tubing @4676- 7 95
				1	1" Adapter 2 21
				1	1" 2 part union 1 62
				1	1" Curb Cock 8 06
				1	Box & Rod 5 00
				1	3/4" Offset tailpiece 50
				1	3/4" Straight tailpiece 50
					29 72

DATE _____

TOWN OF LEXINGTON — BOARD OF PUBLIC WORKS

WATER DIVISION

Sketch of Service Here

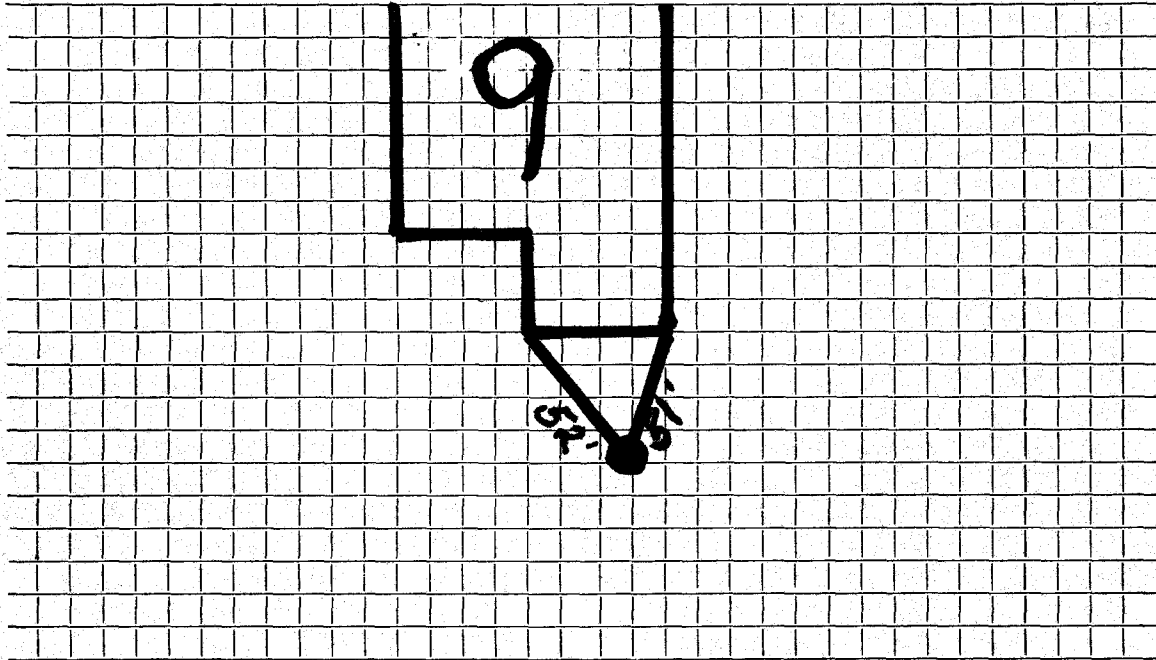

Connection made in Street. Work completed

Remarks: *Original Service 11-6-29*

.....
.....