

**WATER SERVICE RECORD**

Name

Service No.

Address *12 Washington Street*

Location

~~Repair-Renewal~~ - New Service


Date		Material	Amount		Total		Date		Amount
3/28/01	70"	1" Copper							
		3/4" x 1" Adapter							
		1 x 1 Union							
								<i>OUTSIDE</i>	
							5/17/71	Labor	71.94
							13'	Copper	10.27
								3/4" Curb Stop	11.32
							1	Corp. Adaptor	2.76
								Box & Rod	5.10
							1½	Ton Hot Top @ 7.45	11.18
							1	hr. Shovel	4.00
							2	hrs. Trucking	5.25
								Roller, Trailer & Compressor	6.00
									<u>127.73</u>

DATE 3-31-2001

TOWN OF LEXINGTON — BOARD OF PUBLIC WORKS

**WATER DIVISION**

Sketch of Service Here

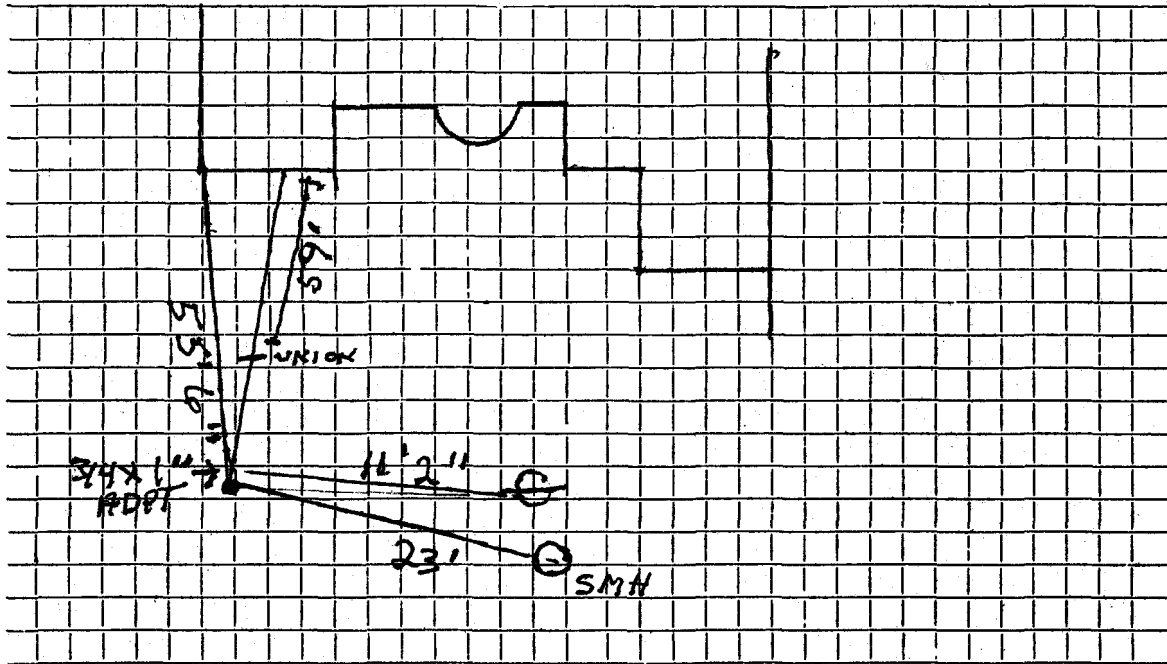

Connection made in WASHINGTON ST. Street.

Work completed ... 3-29-2001 .....

Remarks: ... 3 PART UNION AT 59' .....