




DATE 27 SEPT. 1996

TOWN OF LEXINGTON — BOARD OF PUBLIC WORKS

WATER DIVISION

Sketch of Service Here

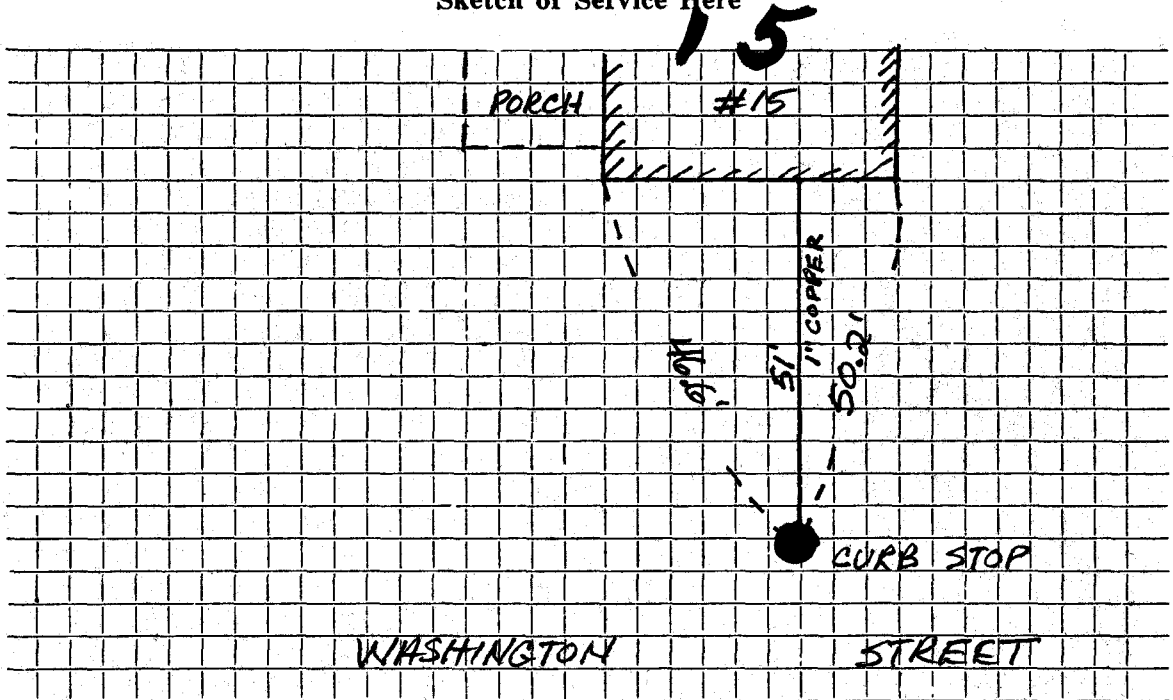

Connection made in WASHINGTON STREET Street. Work completed ARLEX OIL COMPANY

Remarks: SERVICE DEPTH IS ONLY 3.5' DEEP DUE TO LEDGE. WATER SERVICE PLACED WITH R-11 INSULATION WRAP.