




# TOWN OF LEXINGTON — BOARD OF PUBLIC WORKS

## WATER DIVISION

Sketch of Service Here

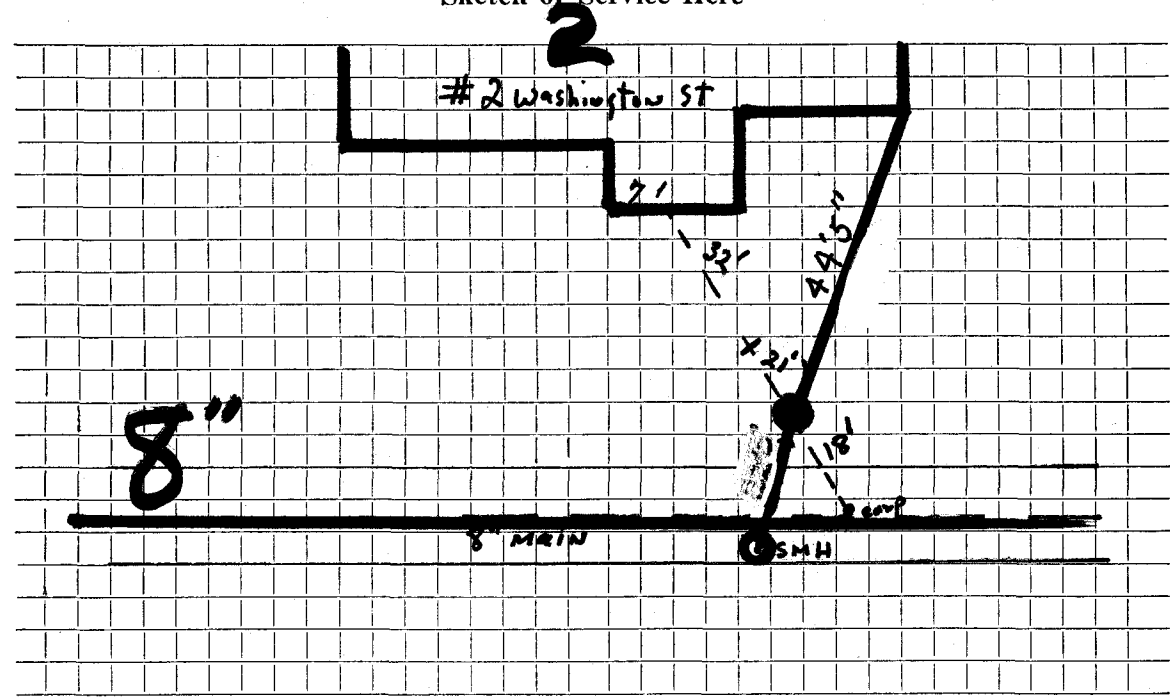

Connection made in Washington ST Street. Work completed .....

Remarks: 1" copper 53' .....

.....  
.....