

Name Leeland Construction Company

Service No. ²⁵⁷⁸ 115

Address 21 Washington Street

Lexington Location 21 Washington Street

Kind of Pipe Size Size of Main

~~Repair-Removal~~ - New Service Com. 9-5-50 Location

| Date | Material | Amount | Total | Date | Amount |
|-------------|--------------------------------|--------|-------|-------------|-------------------------------------|
| June 29 '50 | Labor | 1 30 | | June 29 '50 | 2000 |
| | 10% Overhead | 13 | 1 43 | | |
| | 54' - 3/4" Copper Tubing @ 23¢ | | 12 42 | | 17 89 |
| | 1 - 3/4" C x 1/2" I.W.H S&W | | 3 09 | | No Charge |
| | 1 hr. Trucking | | 75 | June 29 '50 | Labor 1 30 |
| | | | 17 89 | | 21' - 3/4" Copper Tubing @ 23¢ 4 83 |
| | | | | | 1 - 3/4" C. Corp-cock 3 15 |
| | | | | | 1 - 3/4" C x 3/4" C Curb-cock 3 85 |
| | | | | | 1 Box & Rod 3 35 |
| | | | | | 1 - 1/2" Offset Tail Piece 38 |
| | | | | | 1 - 1/2" Straight Tail Piece 38 |
| | | | | | 1 hr. Trucking 75 |
| | Labor | | | | 17 99 |

DATE _____

TOWN OF LEXINGTON - BOARD OF PUBLIC WORKS

WATER DIVISION

The undersigned applies for a supply of water at No..... St. and hereby agrees to comply with the rules and regulations as now, or at any future time, established by the Board of Selectmen.

Am't of Estimate \$.....

Owner


Am't Paid \$.....

Address

Builder

.....

Sketch of Service Here

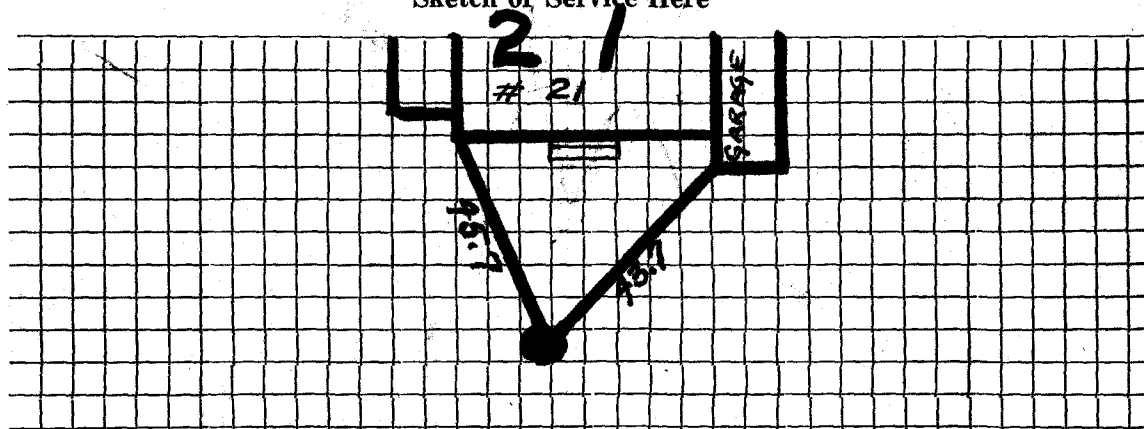

Connection made in Street.

Work completed19

Remarks: