

WATER SERVICE RECORD

# 6477

Name Francis V. McCrory

Service No. 30

Address 4 Washington St.

Location

~~Repair~~ Renewal ~~New Service~~ W. O. # 8132 - 8145

JAN 17 1972


| Date    | Material                   | Amount | Total  | Date           | Amount                     |
|---------|----------------------------|--------|--------|----------------|----------------------------|
| 9/21/71 | Labor                      | 95 64  |        | 9-21-71        | Deposit 755 00             |
| 9/22/71 | "                          | 36 15  |        | 1-17-72        | Refund 396 59              |
|         | 10% O.H.                   | 13 18  | 144 97 |                | 328 41                     |
|         | 100' Copper pipe .99       |        | 99 00  |                |                            |
|         | 1 1" Wheel Valve           |        | 12 53  |                |                            |
|         | 2 3/4" Brass Couplings .98 |        | 1 96   | Sept. 21, 1971 | <u>OUTSIDE</u> Labor 48 03 |
|         | 1 6x3/4" Brass nipple      |        | 2 25   | 1              | Ton cold patch 8 00        |
|         | 8 Yds. Loam 3.50           |        | 28 00  | 2              | Hrs. Truck 3.00 6 00       |
|         | 7 Lbs. grass seed 1.10     |        | 7 70   | 1/2            | Hr. compressor 4.00 2 00   |
|         | 2 Hrs. Trucking 3.00       |        | 6 00   | 1              | " shovel 4 00              |
|         | 4 " Shovel 6.50            |        | 26 00  | 1              | " roller 2 00              |
|         |                            |        | 328 41 |                | 70 03                      |

DATE \_\_\_\_\_

TOWN OF LEXINGTON — BOARD OF PUBLIC WORKS

**WATER DIVISION**

Sketch of Service Here

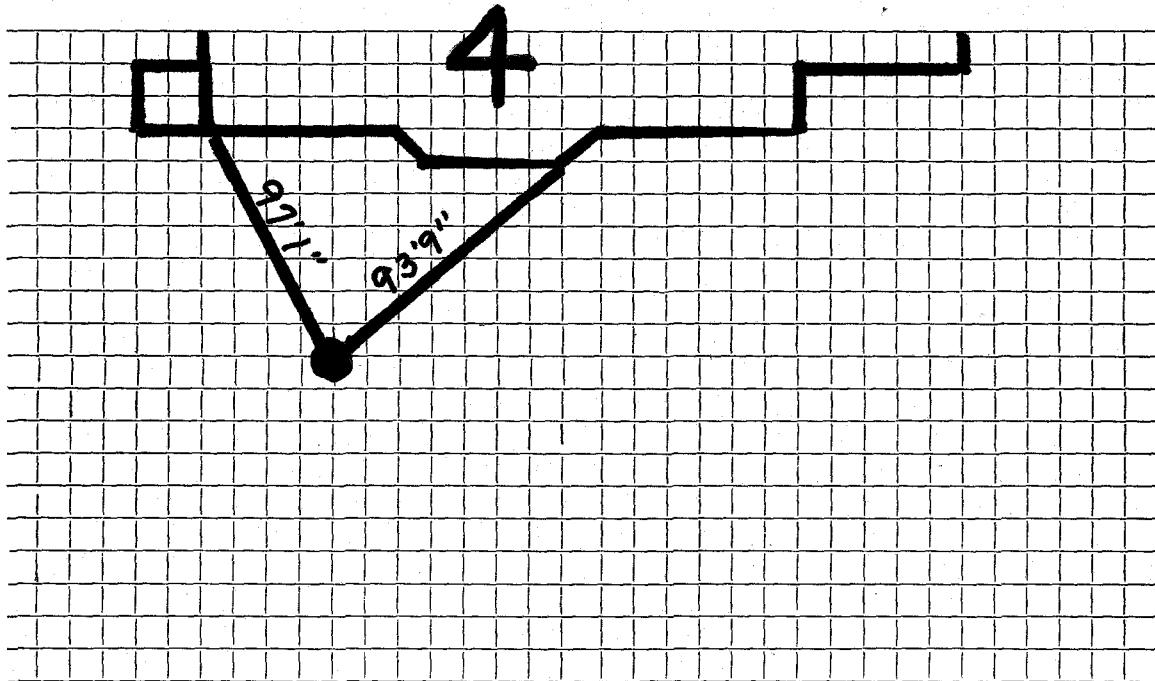

Connection made in ..... Street. Work completed .....

Remarks: .....

.....

.....

Name

Service No. <sup>2915</sup>  
~~2913~~

Address\*

Location *4 Washington Street (Garage)*

Kind of Pipe

Size

Size of Main

Repair—Renewal—New Service

Location

Date

Material

Amount

Total

Date

Amount

Labor

DATE \_\_\_\_\_

# TOWN OF LEXINGTON—BOARD OF PUBLIC WORKS

## WATER DIVISION

The undersigned applies for a supply of water at No. \_\_\_\_\_ St. and hereby agrees to comply with the rules and regulations as now, or at any future time, established by the Board of Selectmen.

Am't. of Estimate \$ \_\_\_\_\_

Owner


Am't. Paid \$ \_\_\_\_\_

Address

Builder \_\_\_\_\_

R. J. Fernald  
4 Washington St  
(Garage)

Sketch of Service Here

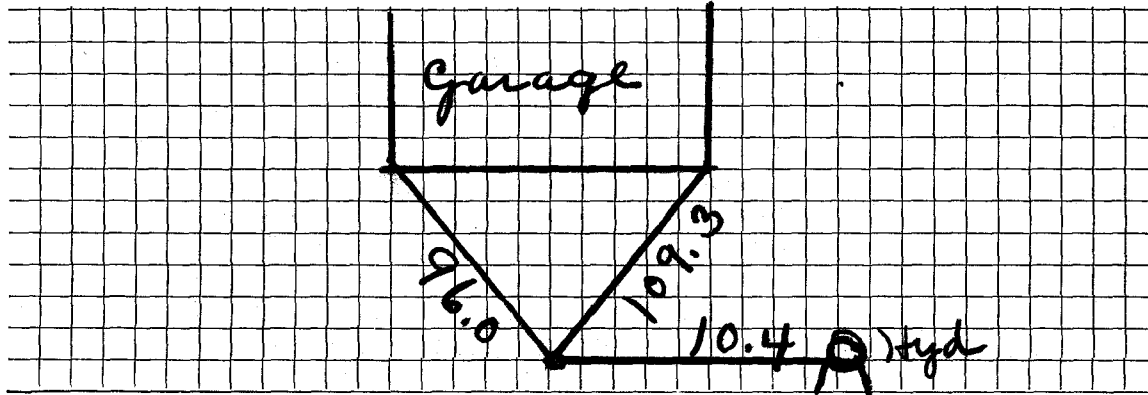

Connection made in \_\_\_\_\_ Street.

Work completed \_\_\_\_\_ 19

Remarks: