

Name Charles H. Schofield

Service No. 56 2916

Address 1840 Mass. Ave.,

#5794

5 Washington St

Location #5 Washington Street

#5504

Kind of Pipe

Size

Size of Main

~~Repair - Renewal - New Service~~

Location

Date	Material	Amount	Total	Date	Amount
1936					
Dec. 2,	20 hrs @ 60¢	12 00			
Com 12.8.36	16 " 55¢	8 80	20 80		
\$37.98	10% Overhead		2 08		
	43' Cop. Tubing @ 20¢		8 60		
	1 S. & W.		1 75		
	Trucking		75		
			33 98		
	Trench Repairs		4 00		
			37 98		
				Jan. 2 1937	Cash 37 98
	Labor				

Bill mailed 12-10-36 \$37.98

Jan. 2 1937 Cash 37 98

Hadley Press, Inc., Lexington

DATE \_\_\_\_\_

# TOWN OF LEXINGTON—BOARD OF PUBLIC WORKS

## WATER DIVISION

The undersigned applies for a supply of water at No. \_\_\_\_\_ St. and hereby agrees to comply with the rules and regulations as now, or at any future time, established by the Board of Selectmen.

Am't. of Estimate \$ \_\_\_\_\_


Owner \_\_\_\_\_

Am't. Paid \$ \_\_\_\_\_

Address \_\_\_\_\_

Builder \_\_\_\_\_

Sketch of Service Here

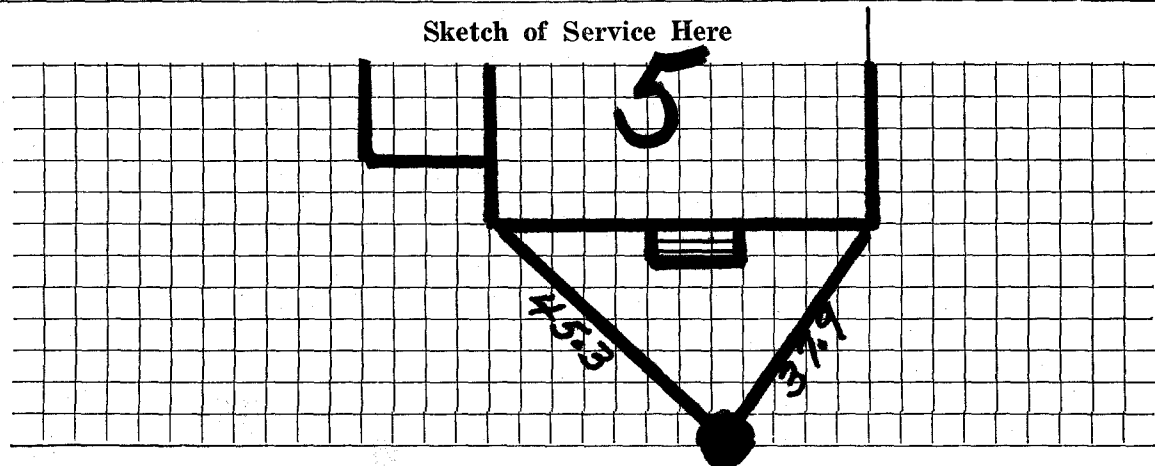

Connection made in \_\_\_\_\_ Street.

Work completed \_\_\_\_\_ 19

Remarks: