


Date: 9/30/22

TOWN OF LEXINGTON - BOARD OF PUBLIC WORKS
WATER DIVISION

SKETCH OF SERVICE HERE

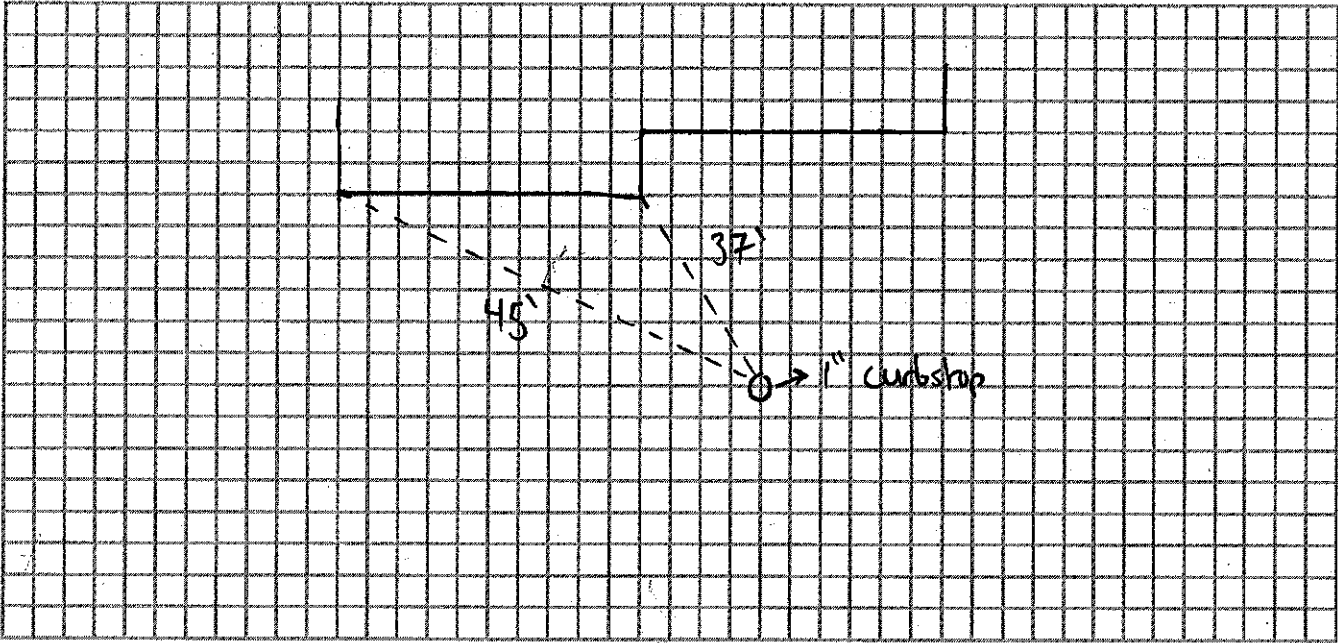

Connection made in: _____ Street: _____ Work completed: _____

Remarks: INSTALLED BY LOVINO
3/4" Line from curbstop to main