

Water Service Record

Name

Service No.

Address

22 Washington St

Location


Repair - Renewal New Service

Date	Material	Amount	Total	Date		Amount
5/6/20	1" type K copper					
	1" curb stop					
	open right					
	cambi brass					
	Buffalo Box					
	1" corporation					

TOWN OF LEXINGTON - BOARD OF PUBLIC WORKS
WATER DIVISION

Date: 5/16/2020

SKETCH OF SERVICE HERE

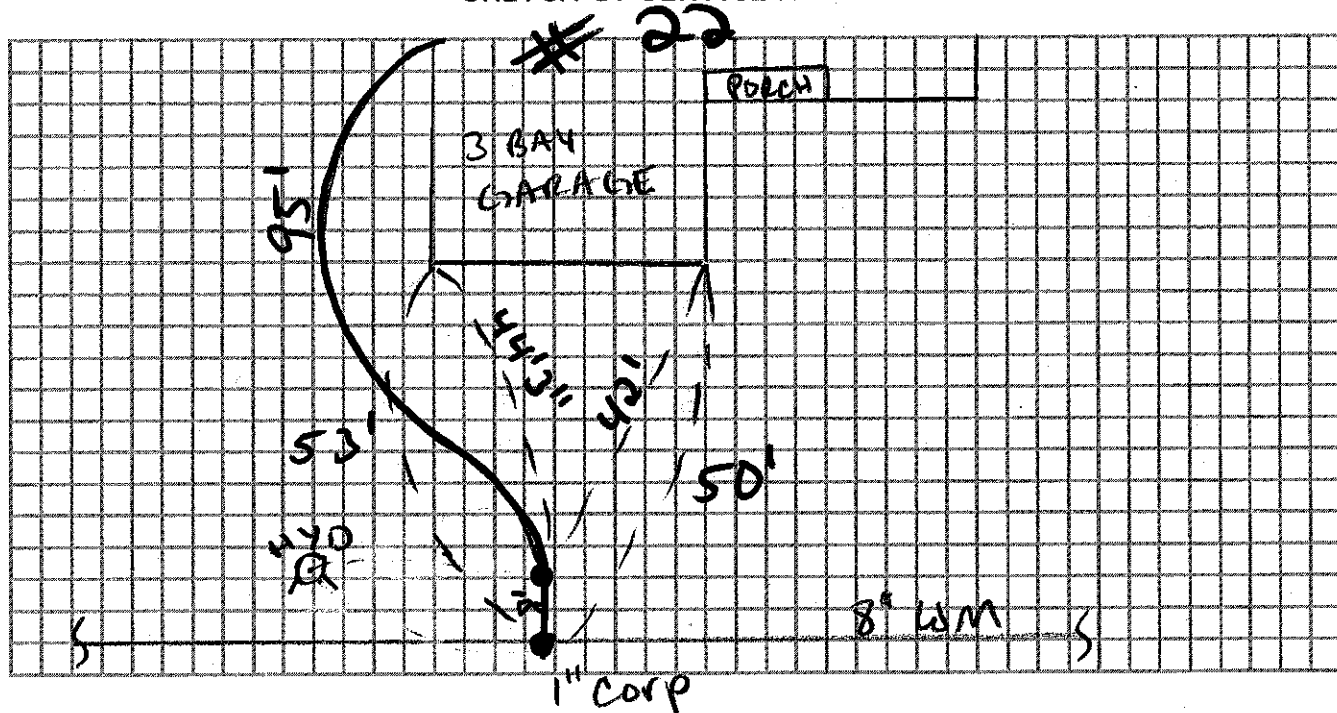

Connection made in: Washington

Street.

Work completed:

Remarks: