

WATER SERVICE RECORD

#4774

Name

Service No.

Address 18 Watertown Street

Location

~~Xxxxxx~~—Renewal—~~New Service~~ W. O. # 8747


| Date | Material | Amount | Total | Date | | Amount |
|----------|--|--------|-------|---------|----------------|---------------------|
| 3-24- 52 | | | | | | |
| | 50' $\frac{3}{4}$ " Copper | | | | | |
| | 1 $\frac{3}{4}$ " C. X $\frac{1}{2}$ " I.W.H. Stop + Waste | | | | | |
| | 1 $\frac{3}{4}$ " C. X $\frac{3}{4}$ " C. Union | | | | | |
| | | | | | <u>OUTSIDE</u> | |
| | | | | 7/12/71 | Labor | 81 52 |
| | | | | 7/13/71 | " | 112 56 |
| | | | | | 15' | Copper pipe .79 |
| | | | | | 1 | 3/4" Union |
| | | | | | 1 | 3/4" Corp. |
| | | | | | $\frac{1}{2}$ | Ton cold patch 8.00 |
| | | | | | 4 | " hot top 7.45 |
| | | | | | 6 | Hrs. Truck 3.00 |
| | | | | | 4 | " Compressor 3.00 |
| | | | | | 3 | " Shovel 4.00 |
| | | | | | 1 | " Roller |
| | | | | | | 215 11 |

DATE _____

TOWN OF LEXINGTON — BOARD OF PUBLIC WORKS

WATER DIVISION

Sketch of Service Here

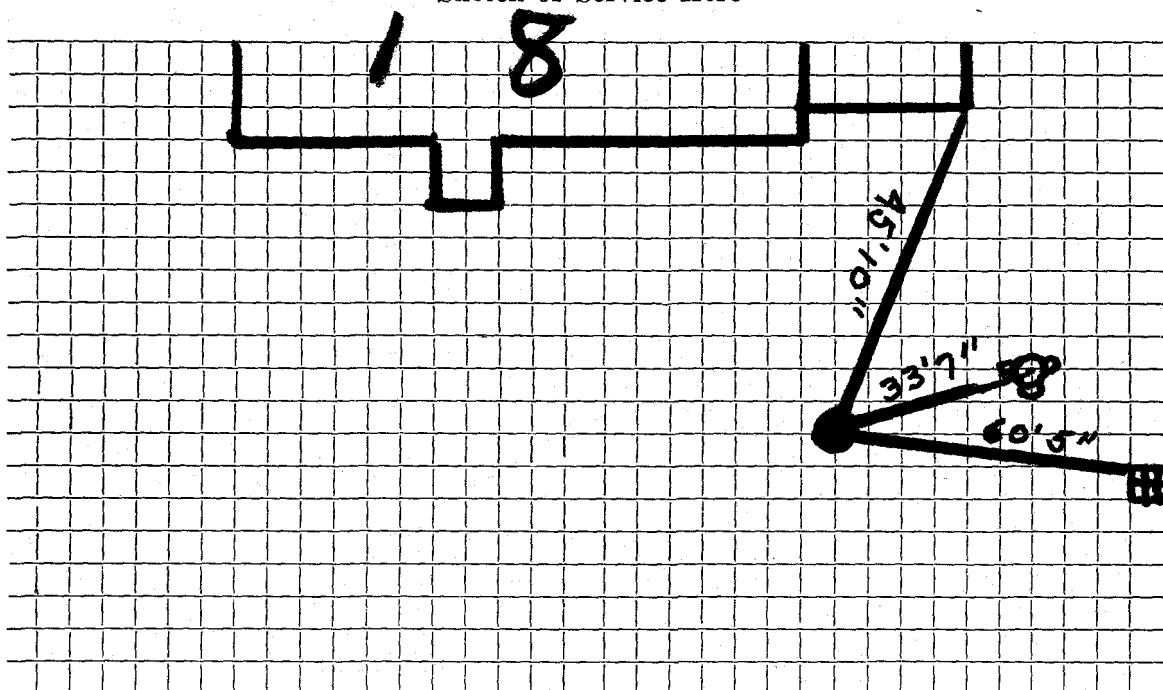

Connection made in Street. Work completed

Remarks: