

WATER SERVICE RECORD

#6702

Name

Service No.

Address # 2 Watertown Street

Location

~~Repair~~ Renewal ~~New Service~~ W. O. # 8773


Date	Material	Amount	Total	Date	Amount
4-15-47	42' $\frac{3}{4}$ " Copper				
	1 $\frac{3}{4}$ " C. X $\frac{1}{2}$ " I.W.H. Stop & Waste				
	1 $\frac{3}{4}$ " C. X $\frac{3}{4}$ " C. 3 Part Union				
					<u>OUTSIDE</u>
				7/23/71	Labor 132 00
				31' $\frac{3}{4}$ " Copper pipe .79	24 49
				1 $\frac{3}{4}$ " Corporation	9 57
				$\frac{1}{2}$ Ton cold patch 8.00	4 00
				1 Hr. Truck	3 00
				3 Hrs. Shovel	12 00
					<u>185 06</u>

DATE _____

TOWN OF LEXINGTON — BOARD OF PUBLIC WORKS

WATER DIVISION

Sketch of Service Here

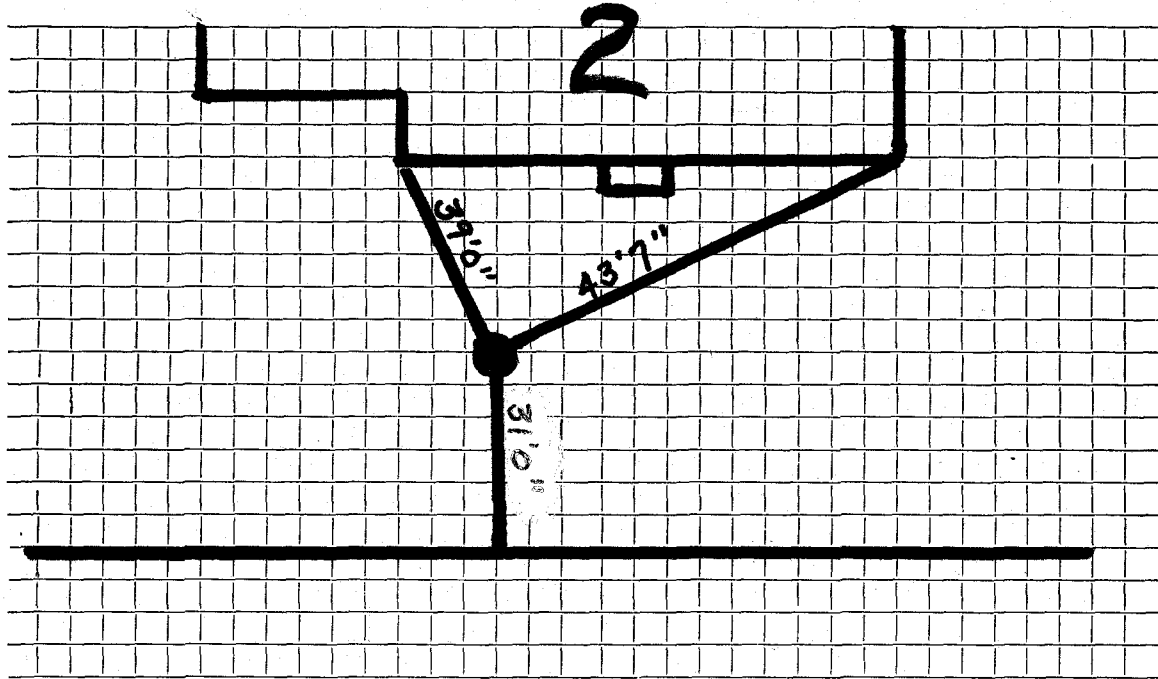

Connection made in Street. Work completed

Remarks:

.....
.....