

WATER SERVICE RECORD

Name

Service No.

Address 26 Watertown Street

Location

~~Repair~~ Renewal ~~NEW SERVICE~~


Date	Material	Amount	Total	Date	Amount
11-19-49					
	43' 3/4" Copper				
	1 3/4" C. X 1/2" I.W.H. STop + Waste				
					NON CHARGE
				4-26-61	Labor 37.17
					55' 3/4" Copper tubing @.42 23.10
					1 3/4" C Corp Cock 4.91
					1 3/4" C Curb Cock 6.28
					1 Box & Rod 4.90
					2 hrs. Town Shovel @6.50 13.00
					1 hr. Trucking @3.00 3.00
					92.36

DATE _____

TOWN OF LEXINGTON — BOARD OF PUBLIC WORKS

WATER DIVISION

Sketch of Service Here

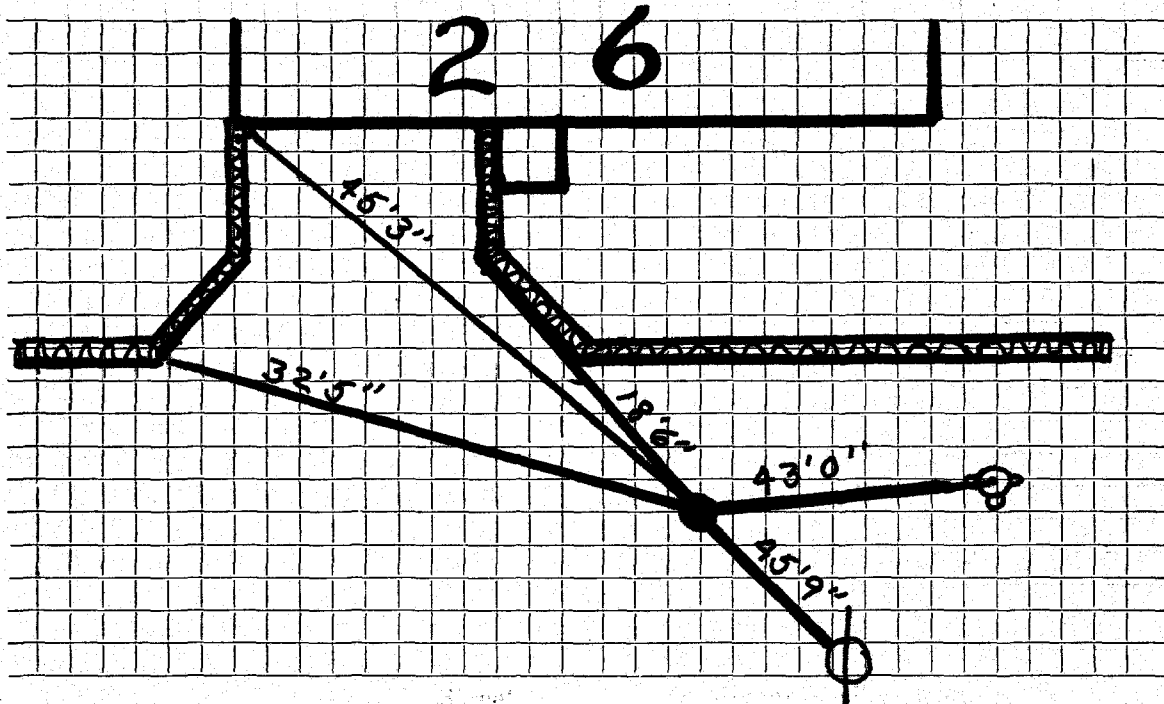

Connection made in Street. Work completed

Remarks:
.....
.....