

WATER SERVICE RECORD

6027

Name

Service No.

Address 28 Watertown Street

1975

Location


Repair—~~Repair~~ New Service

Date	Material	Amount	Total	Date	Amount
9-18-47	88' $\frac{3}{4}$ " Copper				
	1 $\frac{3}{4}$ " C. X $\frac{1}{2}$ " I.W. H. Stop + Waste				
	1 $\frac{3}{4}$ " C. X $\frac{3}{4}$ " C. 3 Part Union				
					NON CHARGE
				10-7-60	Labor 62.10
					30' 1" Copper tubing @.56 16.80
					1 1" C Corp Cock 7.31
					1 1" C Curb Cock 8.06
					1 1" 3 part union 3.98
					2 hrs. Town Shovel @6.50 13.00
					1 hr. Trucking @.75 75
					112.00
					(Service to 12" Main)

TOWN OF LEXINGTON — BOARD OF PUBLIC WORKS

WATER DIVISION

Sketch of Service Here

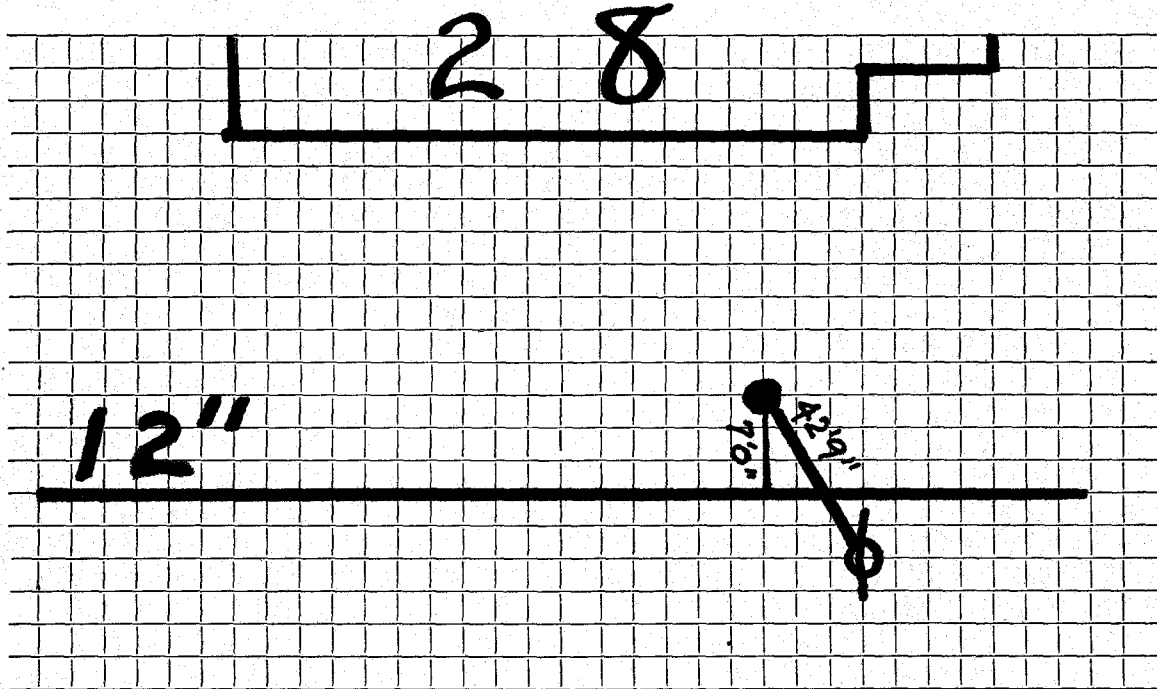

Connection made in Street. Work completed

Remarks:
.....
.....