

WATER SERVICE RECORD

Name

Service No.

Address

30A Watertown Street

Location


Repair - ~~Renewal~~ ~~Service~~

Date	Material	Amount	Total	Date	Amount
1-15-51					
	1 1" C. X 1" I.W.H. Stop + Waste				
	1 1" X 3/4" Brass Bushing				
					NON CHARGE
				10-6-60	Labor 45.55
					52' 1" Copper tubing @.56 29.12
					1 1" C Corp Cock 7.31
					1 1" C Curb Cock 8.06
					1 3/4" 3 part union 2.41
					2 hrs. Town Shovel @6.50 13.00
					2 hrs. Trucking @.75 1.50
					106.95
					(Service to 12" Main)

TOWN OF LEXINGTON — BOARD OF PUBLIC WORKS

WATER DIVISION

Sketch of Service Here

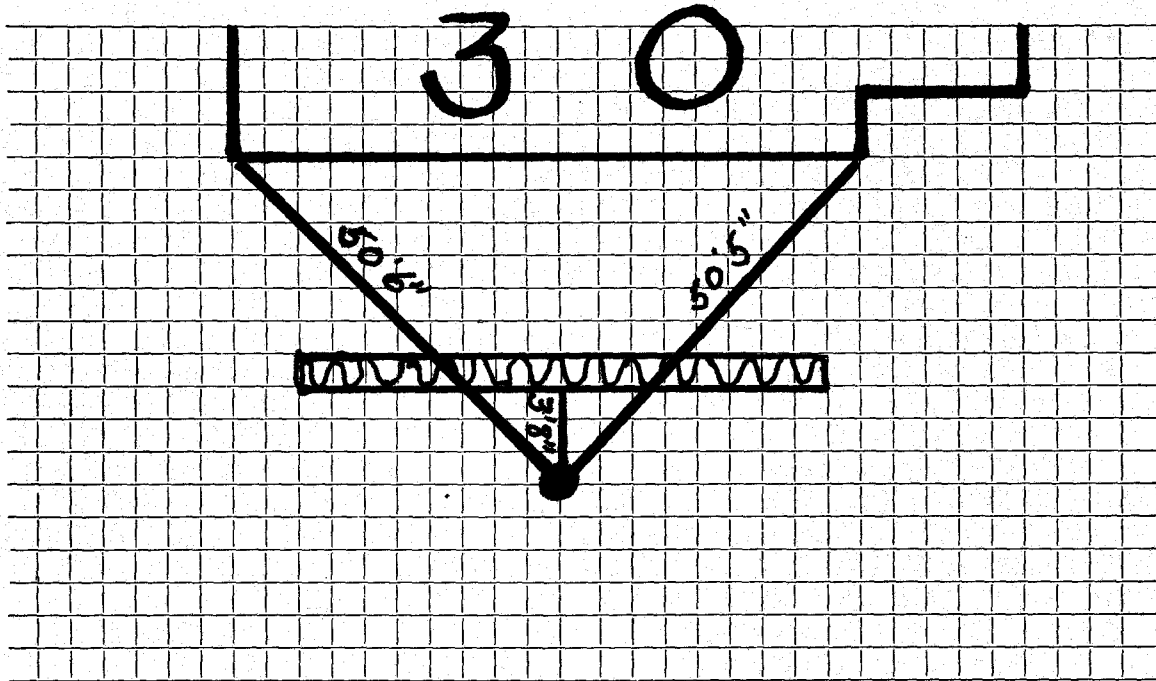

Connection made in Street. Work completed

Remarks:
.....
.....