

## WATER SERVICE RECORD

Name Winston E. Flynn

Service No. 7

Address 32 Watertown St. Lexington, Mass

Location

~~Repair~~ ~~Renewal~~ ~~New Service~~ WO # 4174


Date	Material	Amount	Total	Date	Amount	
3/30/76	labor	32.26		3-29-76	Deposit	75.00
	10% OH	3.22	35.48	8-16-76	Refund	4.87
2'	3/4" copper tubing @ .67		1.34			70.31
1	3 part union-3/4"		4.73	10-6-60	Renewal	
1	yd. loam		4.90		80' 3/4" Copper	
2	yds. gravel @ 2.19		4.38		1 3/4" C. Corp Cock	
2	lbs. grasseed @ .35		.70		1 3/4" C. Curb Cock	
2	hrs. town shovel @ 6.50		13.00		2 3/4" C. 3 Part Union	
2	hrs. trucking @ 3.00		6.00			
			70.13			

DATE \_\_\_\_\_

TOWN OF LEXINGTON — BOARD OF PUBLIC WORKS

**WATER DIVISION**

Sketch of Service Here

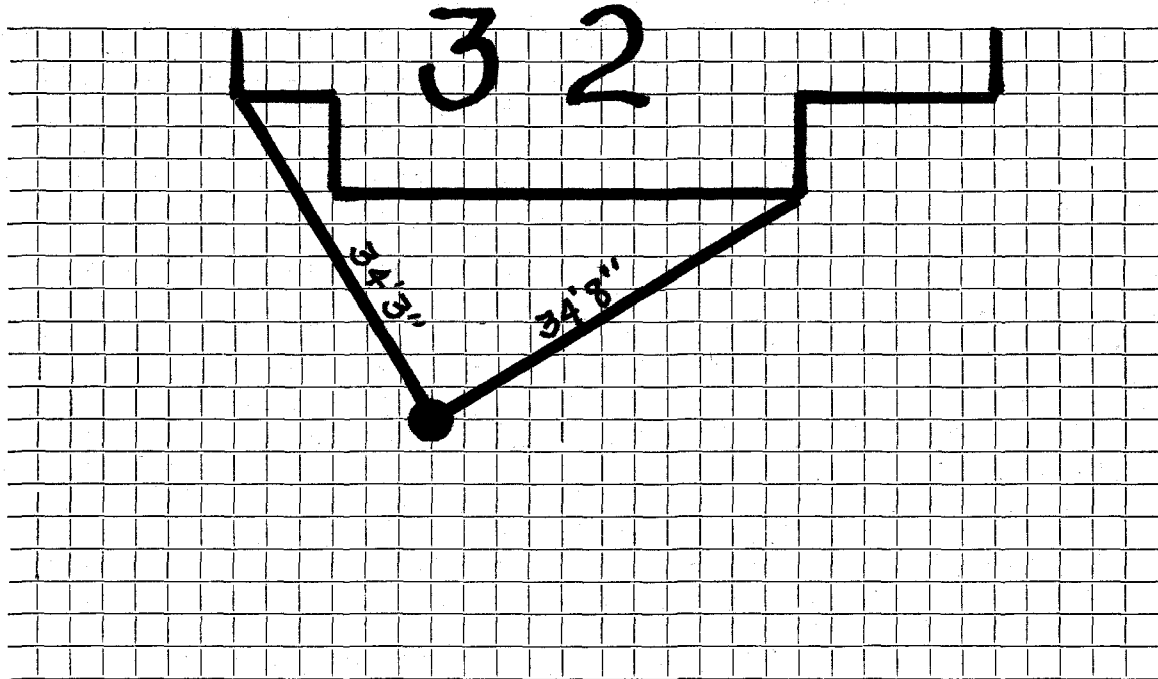

Connection made in ..... Street.      Work completed .....

Remarks: .....  
.....  
.....