

Name Merle Miller, Builder for Lexington Homes, Inc.

Service No. ~~50~~ 2921

Address Lexington, Mass.
41 Watertown St.

Location 41 Watertown St.,

Kind of Pipe

Size

Size of Main

~~Repair~~ ~~Renewal~~ New Service

Location

Date
1940

Material

Amount

Total

Date

Amount

Oct 1,

4 hrs. @ 60¢

2 40

September 26, 1940

Deposited

23 00

Corr 11/18/40

10% Overhead

24

2 64

November 25, 1940

Refused

2 30

50' 1" Copper tubing @ 21¢

10 50

1 1" C.x 1/2" I.S. & W.

2 25

2 hrs. trucking @ 75¢

1 50

Construction charge

3 75

20 64

50 64

Labor

DATE Sept. 5, 1940

TOWN OF LEXINGTON—BOARD OF PUBLIC WORKS

WATER DIVISION

The undersigned applies for a supply of water at No. 41 Watertown St St. and hereby agrees to comply with the rules and regulations as now, or at any future time, established by the Board of Selectmen.

Am't. of Estimate \$ 23⁰⁰

Owner Lexington Homes Inc


Am't. Paid \$ _____

Address Bedford St

Builder McAle McAle *owner doing work on Crescent Rd*

Lexington

Sketch of Service Here

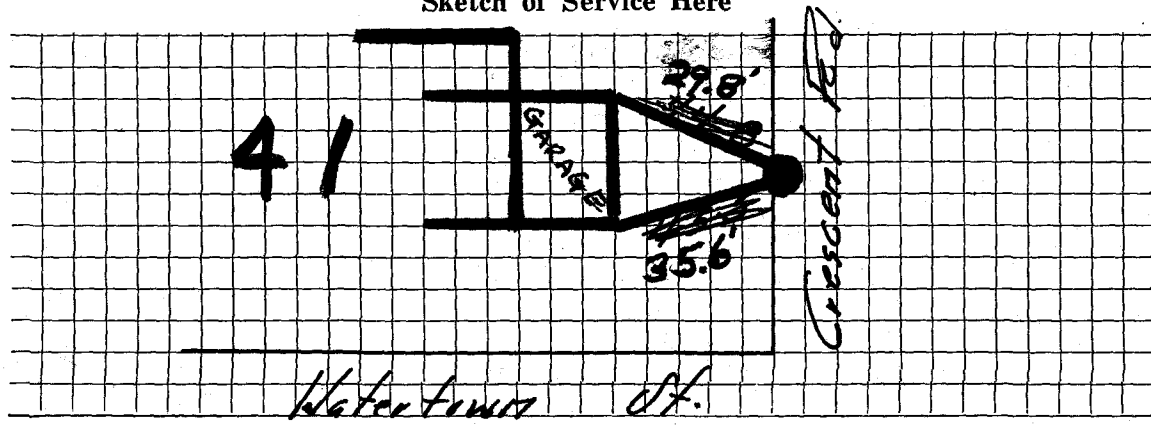

Connection made in _____ Street.

Work completed _____ 19

Remarks: