

Name **George W. Norton**

Service No. ~~107~~ **2922**

Address **46 Watertown Street, Lexington**

Location **46 Watertown St**

Kind of Pipe

Size

Size of Main

~~Repair - Renewal~~ New Service

note: this cost put on wrong card - this card belongs to 189 - Carlson's service will be put on #189 Location

Date	Material	Amount	Total	Date	Amount
<i>P12-6-27 for 66.39</i>	63' 1 1/4" C.L. Pipe @ .35	22 05			
	3 1 1/4" L.L. Coup. @ .35	1 05		<i>Dec. 19 1927 - Cash</i>	66 39
	1 1 1/4" L.L. Ell	45			
	1 1 1/4" x 1" L.L. Ell	50			
	2 1" Br. Cl. Nip. @ .25	50			
	1 S & W	2 75			
	1 1 1/4" x 1" L.L. Red. Coup.	25			
	Trucking	75	28 30		
<i>12/1/27</i>	47 Hrs. Labor @ .55	25 85			
	2 " " @ .60	1 20			
	8 ² " " @ .70	6 07	33 12		
	Labor 15% overhead		4 97		
			<u>66 39</u>		

Hadley Press, Inc., Lexington

DATE December 13, 1927

TOWN OF LEXINGTON—BOARD OF PUBLIC WORKS

WATER DIVISION

46 Waterford St.

The undersigned applies for a supply of water at No. Lot 415 Westminister Ave. St. and hereby agrees to comply with the rules and regulations as now, or at any future time, established by the Board of Selectmen.

Am't. of Estimate \$ 50⁰⁰

Owner August W. Carlson


Am't. Paid \$ 30⁰⁰

Address 16 Laurel St.

Builder _____

Lexington

Sketch of Service Here

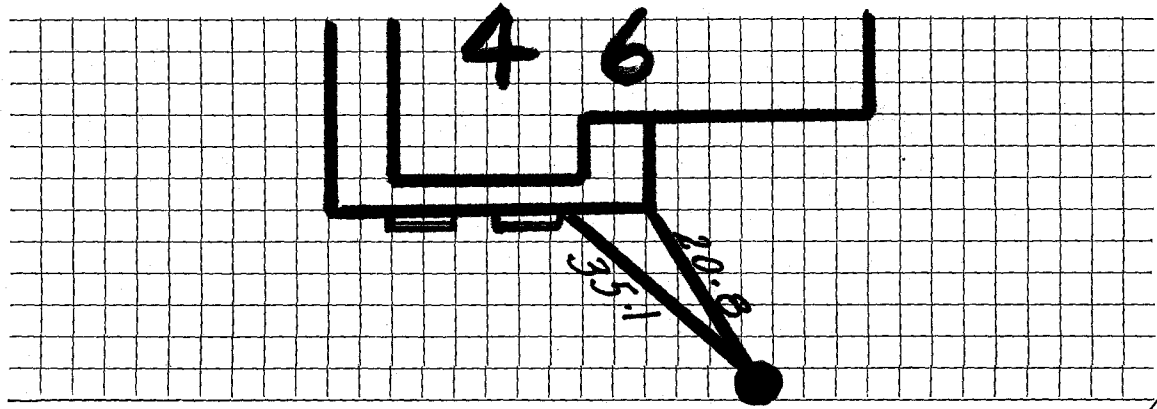

Connection made in _____ Street.

Work completed 12/16/27 19

Remarks: