

Name J. R. Fitzpatrick

Service No. ~~104~~ 2924

Address 56 Watertown Street

Location 56 Watertown St.

Kind of Pipe

Size

Size of Main

~~Repair - Renewal -~~ New Service

Location

Date	Material	Amount	Total	Date	Amount
P. 12-6-27 for 150.00	128' 1" C.L. Pipe @ .27	34 56			
	6 1" L.L. Coup. @ .25	1 50			
	1 1" L.L. Ells @ .30	30			
	1 1" Br. Cl. Nipple	25			
	1 S & W	2 75			
	Trucking	1 75	41 11		
11/1/27	90 Hrs. Labor @ .55	49 50			
	3 " " @ .60	1 80			
	8 ² " " @ .70	6 07			
	3 " " @ .65	1 95	59 32		
	15% Overhead		8 90		
	8' Labor by machine @ .75	6 00			
	2# Dynamite @ .50	1 00			
	5 Caps @ .08	40	7 40		
			116 73		
Dec. 10	Return		# 32 27		
			150 00		

~~Nov. 25 1937 - Cash 150 00~~

W.O. #5364 - WATER SERVICE KILLED - 8/21/67

Hadley Press, Inc., Lexington

DATE November 28, 1927

TOWN OF LEXINGTON—BOARD OF PUBLIC WORKS

WATER DIVISION

The undersigned applies for a supply of water at No. Watertown Street St. and hereby agrees to comply with the rules and regulations as now, or at any future time, established by the Board of Selectmen.

Am't. of Estimate \$ 300⁰⁰

Owner

Mrs J. R. Fitzpatrick


Am't. Paid \$ 150⁰⁰ 11-28-27

Address

Watertown St
East Lexington

Builder _____

Sketch of Service Here

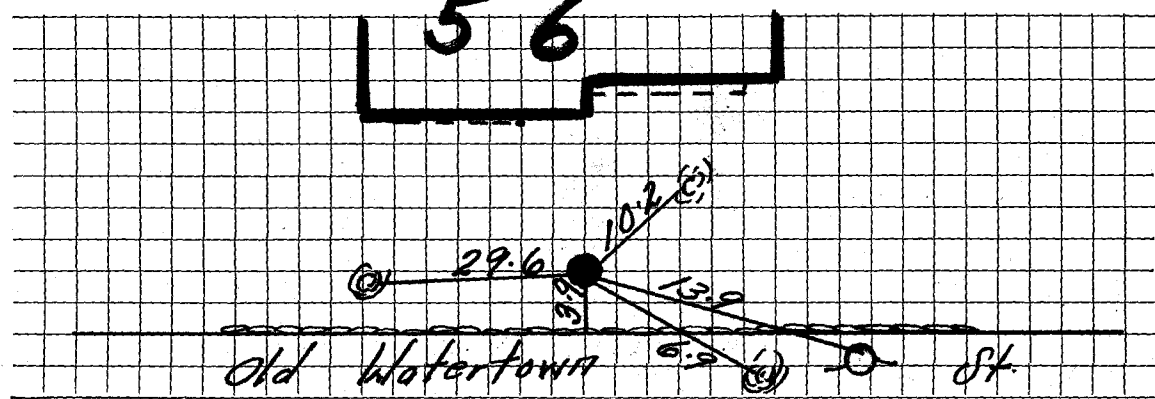

Connection made in Watertown Street.

Work completed _____ 19

Remarks: