

Name Gurich Associates

Service No.

81 # 3564

Address 3 Watson Road

Lexington, Mass.

Location 3 Watson Road

Kind of Pipe

Size

Size of Main

~~REPEATED~~—New Service

Com. 6-11-49

Location

Date	Material	Amount	Total	Date	Amount
May 25, '49	Labor	1 15	1 15	May 19, '49	15 00
	10% Overhead		12		
	31' - 3/4" Copper Tubing @.24		7 44		No Charge
	1 - 3/4" C x 1/2" I.W.H. S&W		3 29	May 25, '49	Labor 1 15
	1 - 3/4" C x 3/4" C Union (3pts)		1 39		24' - 3/4" Copper Tubing @.24 5 76
	Trucking 1 hr. @.75		75		1 - 3/4" C Corp-cock 3 15
			14 14		1 - 3/4" C x 3/4" C Curb-cock 3 85
					1 - Box & Rod 3 95
					1 - 1/2" Straight Tail Piece 37
					1 - 1/2" Offset Tail Piece 37
					Trucking 1 hr. @.75 75
					19 35
	Labor				

DATE _____

TOWN OF LEXINGTON – BOARD OF PUBLIC WORKS

WATER DIVISION

The undersigned applies for a supply of water at No..... St. and hereby agrees to comply with the rules and regulations as now, or at any future time, established by the Board of Selectmen.

Am't of Estimate \$.....

Owner


Am't Paid \$.....

Address

Builder

.....

Sketch of Service Here

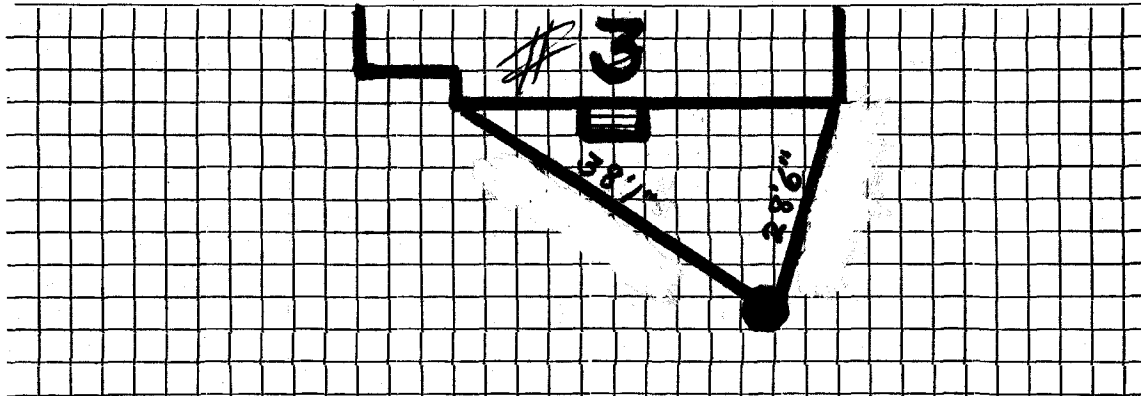

Connection made in Street.

Work completed19

Remarks: